

STONE  
F-10  
6-15-71

MISSISSIPPI  
BOARD OF WATER COMMISSIONERS  
416 North State Street  
Jackson, Mississippi 39201

**CODED**

WATER WELL DRILLERS LOG

6-15 1971 Parwell Andrews Stone  
date well completed firm name county well located

LANDOWNER: Dottie Kennedy  
Route 2, Perkinston  
(mailing address)

description of formations encountered	from	to
TOP SOIL	0	2
Red Sand	2	18
Red clay	18	27
SANDS with clay ST	27	86
Red clay	86	115
Fine Sand + Clay ST	115	121
Fine Sand	121	170
Pink Clay	170	174
Coarse Sand	174	186

WELL LOCATION:  
sec. 10 T-3 N R-12 E  
S W  
5 miles W of Perkinston  
(distance) (direction) (nearest town)

WELL PURPOSE: Home  
(home, irrigation, municipal, industrial)

WELL COMPLETION DATA:


(1) diameter (inches) 2  
(2) total depth (feet) 186  
(3) static water level (feet) 98 below top of ground.  
(4) casing Plastic 180 (material) (depth)  
(size) if telescope see back.  
(5) screen 6 (length) (depth to top)  
2 Plastic (size) (material)  
(6) pump 1 5 (HP) (yield gpm)  
(type power)  
(7) electric log (yes or no)  
(organization running log)  
(8) how well bottom plugged Backwash valve

DRILLERS REMARKS:

AUG 30 1971

If well telescopes please sketch and show depths.

GROUND LEVEL

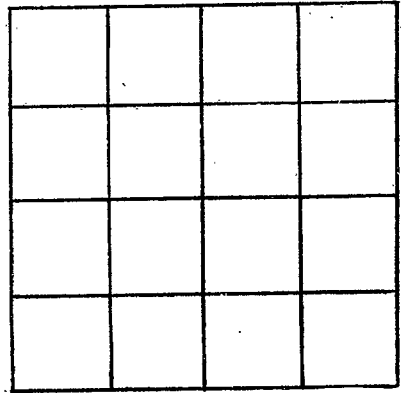

SECTION \_\_\_\_\_

Please indicate well location X.

ADDITIONAL INFORMATION

If more than one screen, show locations of each on sketch.