

STONE
F 15
4-14-72

MISSISSIPPI
BOARD OF WATER COMMISSIONERS
416 North State Street
Jackson, Mississippi 39201

CODED

WATER WELL DRILLERS LOG

4-14 1972 Parnell Anderson Stone
date well completed firm name county well located

LANDOWNER: Nolan Evans
RT 2 Perkinston

(mailing address)

description of formations encountered

from to

TOP Soil	0	3
Red Sand	3	24
Red Clay	24	29
FINE SAND & CLAYST	29	54
Coarse Sand & Gravel	54	70

WELL LOCATION:

sec. 33 T 3 S R 12 W
5 miles W of Perkinston
(distance) (direction) (nearest town)

WELL PURPOSE: Home
(home, irrigation, municipal, industrial)

WELL COMPLETION DATA:

- (1) diameter (inches) 2
- (2) total depth (feet) 70
- (3) static water level (feet) 47 below top of ground.
- (4) casing Plastic, 65' (material) (depth)
(size) if telescope see back.
- (5) screen 5' 65' (length) (depth to top)
2" Plastic (size) (material)
- (6) pump 1 (HP) 11 (yield gpm)
ELECT (type power)
- (7) electric log (yes or no)

(organization running log)

(8) how well bottom plugged
Backwash Valve

DRILLERS REMARKS:


CODED

MISSISSIPPI

MISS

If well telescopes please sketch and show depths.

GROUND LEVEL

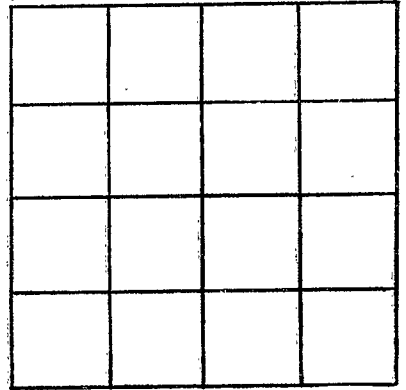

SECTION _____

Please indicate well location X.

ADDITIONAL INFORMATION

If more than one screen, show locations of each on sketch.