

STONE  
FIN  
2-15-74

MISSISSIPPI  
BOARD OF WATER COMMISSIONERS  
416 North State Street  
Jackson, Mississippi 39201

CODED

WATER WELL DRILLERS LOG

2-15-1974 date well completed  
Parnell Anderson firm name  
Stone county well located


LANDOWNER:	description of formations encountered	from	to
Clinas Parker	Top Soil	0	4
Rt 2 Durk (mailing address)	Fine Sand	4	38
WELL LOCATION:	White Clay	38	45
sec 26 T 3 S R 12 E	Blue Clay	45	65
2 miles S of PERK (distance) (direction) (nearest town)	Cannel Sand	65	85
WELL PURPOSE: HOME (home, irrigation, municipal, industrial)			
WELL COMPLETION DATA:			
(1) diameter (inches) 2"			
(2) total depth (feet) 85'			
(3) static water level (feet) 28' below top of ground.			
(4) casing Plastic 50' (material) (depth)			
If telescope see back. (size)			
(5) screen 5' 80' (length) (depth to top)			
2" Plastic (size) (material)			
(6) pump 1/2 6 (HP) (yield gpm)			
Elect (type power)			
(7) electric log no (yes or no)			
(organization running log)			
(8) how well bottom plugged Back not water			
DRILLERS REMARKS:			

CODED

MAR - 6 1974

If well telescopes please sketch and show depths.

GROUND LEVEL

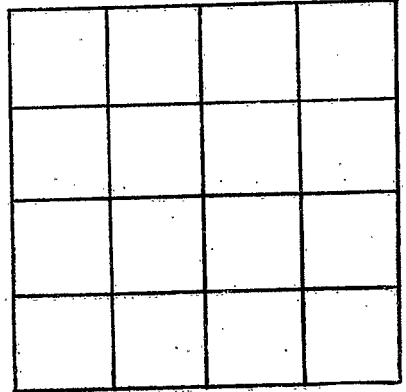

SECTION \_\_\_\_\_

Please indicate well location X.

ADDITIONAL INFORMATION

If more than one screen, show locations of each on sketch.