

CODED

Stone  
7-22  
7-10-69

MISSISSIPPI  
BOARD OF WATER COMMISSIONERS  
416 North State Street  
Jackson, Mississippi 39201

WATER WELL DRILLERS LOG

7-10 1969 L.W. Smith Stone  
date well completed firm name county well located

LANDOWNER:  
Henry O'Quinn  
(mailing address)

description of formations encountered	from	to
	Top 2	0
Clay	2	55
Sand	55	85

WELL LOCATION:  
sec. 24 T 3 S R 12 W  
1 miles W of Perkinsten  
(distance) (direction) (nearest town)

WELL PURPOSE:  
(home, irrigation, municipal, industrial)

- WELL COMPLETION DATA:
- (1) diameter (inches) 2
  - (2) total depth (feet) 85
  - (3) static water level (feet) 55 below above top of ground.
  - (4) casing (Plastic) 85 (material) (depth)
  - (size) if telescope see back.
  - (5) screen 5' 80' (length) (depth to top)
  - (size) (material)
  - (6) pump 1 12 (HP) (yield gpm)
  - (type power)
  - (7) electric log (yes or no)
  - (organization running log)
  - (8) how well bottom plugged B.W.


DRILLERS REMARKS:

UNIT 3 - 1969

MISS. Bd. of  
WATER COMM.

If well telescopes please sketch and show depths.

GROUND LEVEL

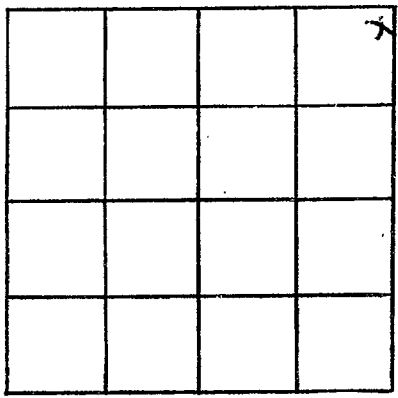

SECTION 24

Please indicate well location X.

ADDITIONAL INFORMATION

A series of horizontal lines for recording additional information.

If more than one screen, show locations of each on sketch.