

STONE
F 23
1-24-70

MISSISSIPPI
BOARD OF WATER COMMISSIONERS
416 North State Street
Jackson, Mississippi 39201

CODED

WATER WELL DRILLERS LOG

1-24 1970 Parnell Anderson STONE
date well completed firm name county well located

LANDOWNER: Bobby Daniels
Perkinston Miss
(mailing address)

description of formations encountered	from	to
Top Soil	0	5
Sand	5	18
Blue Clay	18	32
Red Clay	32	38
Fine Sand	38	75
Coarse Sand	75	106

WELL LOCATION:
sec. 24 T. 3^W R. 12^E
1/2 miles S of Perkinston
(distance) (direction) (nearest town)

WELL PURPOSE:
(home, irrigation, municipal, industrial)

WELL COMPLETION DATA:

(1) diameter (inches) 2"
(2) total depth (feet) 106
(3) static water level (feet) _____ below above top of ground.
(4) casing Plastic, 100 (material) (depth)
(size) If telescope see back.
(5) screen 6' 100 (length) (depth to top)
2" (size) (material)
(6) pump 1/2 5 (HP) (yield gpm)
Elect (type power)
(7) electric log _____ (yes or no)
(organization running log)
(8) how well bottom plugged _____


DRILLERS REMARKS:

FEB 1 1970

MISSISSIPPI
BOARD OF WATER COMMISSIONERS
416 NORTH STATE STREET
JACKSON, MISSISSIPPI 39201

If well telescopes please sketch and show depths.

GROUND LEVEL

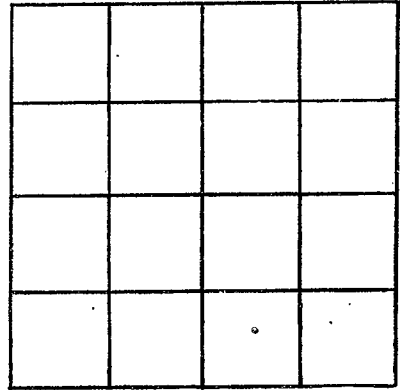

SECTION _____

Please indicate well location X.

ADDITIONAL INFORMATION

If more than one screen,
show locations of each on sketch.