

STONE
F 27
4-26-71

MISSISSIPPI
BOARD OF WATER COMMISSIONERS
416 North State Street
Jackson, Mississippi 39201

CODED

WATER WELL DRILLERS LOG

4-26 1971 Parnee Anderson Stone
date well completed firm name county well located

LANDOWNER Thurman Smith
PERKINSON
(mailing address)

description of formations encountered	from	to
TOP Soil	0	2
Red Clay	2	16
Sand with clay streaks	16	47
Red Clay	47	71
Fine Sand	71	92
Coarse Sand	92	106

WELL LOCATION:
sec 24 T 3 S R 12 E W
miles of (distance) (direction) (nearest town)

WELL PURPOSE: Home
(home, irrigation, municipal, industrial)

- WELL COMPLETION DATA:
- (1) diameter (inches) 2"
 - (2) total depth (feet) 106
 - (3) static water level (feet) 18 below top of ground.
 - (4) casing Plastic 100'
(material) (depth)
 - (size) if telescope see back.
 - (5) screen 6" 100'
(length) (depth to top)
 - (size) Plastic
(material)
 - (6) pump 1/2 5
(HP) (yield gpm)
 - (type power)
 - (7) electric log no
(yes or no)
 - (organization running log)

CODED

JUN 3 1971


(8) how well bottom plugged Barburas & Value

DRILLERS REMARKS:

MISS. DR. ...
MISSISSIPPI ...

If well telescopes please sketch and show depths.

GROUND LEVEL

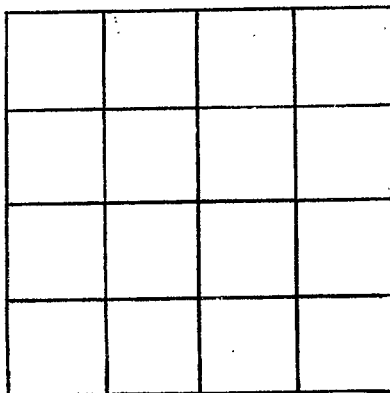

SECTION _____

Please indicate well location X.

ADDITIONAL INFORMATION

If more than one screen, show locations of each on sketch.