

STONE

F 28

4-16-74

MISSISSIPPI BOARD OF WATER COMMISSIONERS

416 North State Street Jackson, Mississippi 39201 CODED

WATER WELL DRILLERS LOG

4-16 1974 Parnell Anderson Stone date well completed firm name county well located

LANDOWNER:

Howard Parker

description of formations encountered

Top Soil

from to

0 4

Rt 2 Deak (mailing address)

Pink Clay 4 14

WELL LOCATION:

sec. 7 T. 3 S. R. 12 E. 5 miles W of Deak (distance) (direction) (nearest town)

White Clay 14 34

Blue Clay 34 180

Coarse Sand 180 191

WELL PURPOSE: HOME (home, irrigation, municipal, industrial)

WELL COMPLETION DATA:

- (1) diameter (inches) 2"
(2) total depth (feet) 191'
(3) static water level (feet) 96' below top of ground
(4) casing Plastic, 186' (material) (depth)

CODED

- (5) screen 5' length, 186' depth to top, 2" Plastic (size) (material)


- (6) pump 1 HP, 6 yield gpm

- (7) electric log No (yes or no)

(organization running log)

- (8) how well bottom plugged Back wash valve

DRILLERS REMARKS:

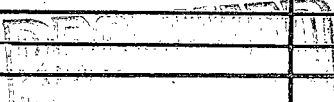

JUN 16 1974

If well telescopes please sketch and show depths.

GROUND LEVEL

| | | | |
|--|--|--|--|
| | | | |
| | | | |
| | | | |
| | | | |

SECTION _____

Please indicate well location X.

ADDITIONAL INFORMATION

If more than one screen,
show locations of each on sketch.