

STONE
F30
7-8-74

MISSISSIPPI
BOARD OF WATER COMMISSIONERS
416 North State Street
Jackson, Mississippi 39201

CODED

WATER WELL DRILLERS LOG

7-8
date well completed

1974 Carnell Anderson Stone
firm name

county well located

LANDOWNER:
John Brent
Rt 2 Perkinston
(mailing address)

description of formations encountered

from to

Top Soil 0 4
Coarse Sand 4 30

WELL LOCATION:
sec. 14 T. 3 S. R. 12
2 miles W of Perk
(distance) (direction) (nearest town)

WELL PURPOSE: HOME
(home, irrigation, municipal, industrial)

WELL COMPLETION DATA:

- (1) diameter (inches) 2"
(2) total depth (feet) 30'
(3) static water level (feet) 22' below top of ground.
(4) casing Plastic 25'
(material) (depth)

CODED

_____ if telescope see back.
(size)

- (5) screen 5" 25'
(length) (depth to top)
2" Plastic
(size) (material)

- (6) pump 1 4
(HP) (yield gpm)
Elect
(type power)

- (7) electric log no
(yes or no)

_____ (organization running log)

- (8) how well bottom plugged
Plugged


DRILLERS REMARKS:

RECEIVED

AUG - 2 1974

If well telescopes please sketch and show depths.

GROUND LEVEL

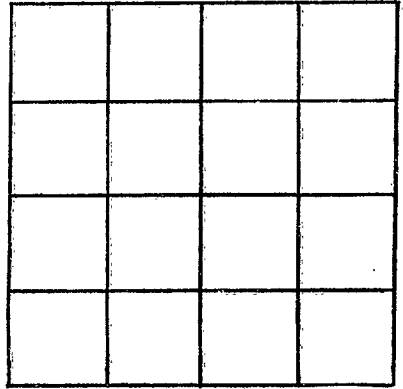

SECTION _____

Please indicate well location X.

ADDITIONAL INFORMATION

If more than one screen, show locations of each on sketch.