

STONE

F31

7-1-74

MISSISSIPPI  
 BOARD OF WATER COMMISSIONERS  
 416 North State Street  
 Jackson, Mississippi 39201

CODED

WATER WELL DRILLERS LOG

7-1  
date well completed

1974 Parnell Henderson Stone  
firm name

county well located

LANDOWNER:

Pattee Lee

Rt 2 Dek

(mailing address)

description of formations encountered

Top Soil

from 0 to 4

Fine Sand

4 to 78

Coarse Sand 78 to 85

WELL LOCATION:

sec 24 T 3 R 12

2 miles SE of Dek  
(distance) (direction) (nearest town)

WELL PURPOSE:

HOME  
(home, irrigation, municipal, industrial)

CODED

WELL COMPLETION DATA:

- (1) diameter (inches) 2"
- (2) total depth (feet) 85'
- (3) static water level (feet) 35' below top of ground.
- (4) casing Plastic 80'  
(material) (depth)

\_\_\_\_\_ if telescope see back.  
(size)

- (5) screen 5' 80'  
(length) (depth to top)
- 2" Plastic  
(size) (material)

- (6) pump 1 11  
(HP) (yield gpm)
- Electric  
(type power)

- (7) electric log no  
(yes or no)

\_\_\_\_\_ (organization running log)

- (8) how well bottom plugged Plugged


DRILLERS REMARKS:

REMOVED

AUG - 2 1974

If well telescopes please sketch and show depths.

GROUND LEVEL

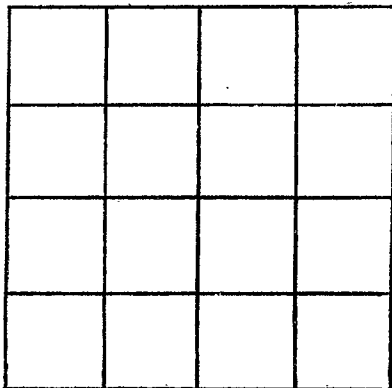

SECTION \_\_\_\_\_

Please indicate well location X.

ADDITIONAL INFORMATION

If more than one screen,  
show locations of each on sketch.