

STONE
F 33
10/14/74

MISSISSIPPI
BOARD OF WATER COMMISSIONERS
416 North State Street
Jackson, Mississippi 39201

CODED

WATER WELL DRILLERS LOG

10-14 1974 Parrell Anderson Stone
date well completed firm name county well located

LANDOWNER:
W.E. Brown

(mailing address)

WELL LOCATION:
sec. 25 T 3 R 12 E
S S W
2 miles S of Park
(distance) (direction) (nearest town)


WELL PURPOSE: HOME
(home, irrigation, municipal, industrial)

- WELL COMPLETION DATA:
- (1) diameter (inches) 2"
 - (2) total depth (feet) 105'
 - (3) static water level (feet) 52' below top of ground.
 - (4) casing Plastic 100'
(material) (depth)

(size) if telescope see back.
 - (5) screen 5' 100'
(length) (depth to top)
2" Plastic
(size) (material)
 - (6) pump 1 10
(HP) (yield gpm)
E. Vest
(type power)
 - (7) electric log no
(yes or no)
 - (organization running log)
 - (8) how well bottom plugged
Plugged

description of formations encountered	from	to
<u>Top Soil</u>	<u>0</u>	<u>3</u>
<u>Fine Sand</u>	<u>3</u>	<u>38</u>
<u>Blue Clay</u>	<u>38</u>	<u>45</u>
<u>White Clay</u>	<u>45</u>	<u>63</u>
<u>Coarse Sand</u>	<u>63</u>	<u>105</u>

CODED

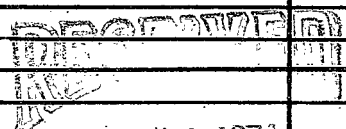


NOV 12 1974

DRILLERS REMARKS:

If well telescopes please sketch and show depths.

GROUND LEVEL

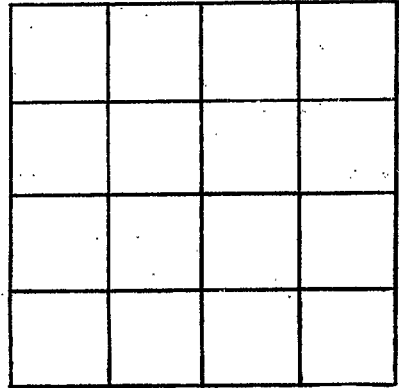

SECTION _____

Please indicate well location X.

ADDITIONAL INFORMATION

A series of horizontal lines providing space for additional information.

If more than one screen, show locations of each on sketch.