

Stone
 F 35
 6-20-75

MISSISSIPPI
 BOARD OF WATER COMMISSIONERS
 416 North State Street
 Jackson, Mississippi 39201

CODED

WATER WELL DRILLERS LOG

6-20-75 date well completed
 1975 firm name
 Pearl Anderson Stone county well located


LANDOWNER:	description of formations encountered	from	to
Robinson Hickman	Top Soil	0	3
(mailing address)	Sandy Clay	3	34
WELL LOCATION:	Thin sand	34	48
sec. 34 T 3 R 12 135	Coarse sand	48	65
4 miles SW of Perk.			
(distance) (direction) (nearest town)			
WELL PURPOSE: HOME			
(home, irrigation, municipal, industrial)			
WELL COMPLETION DATA:			
(1) diameter (inches) 2"			
(2) total depth (feet) 65'			
(3) static water level (feet) 30' below top of ground.			
(4) casing (material) Plastic (depth) 60'			
(size) if telescope see back.			
(5) screen (length) 5' (depth to top) 60'			
(size) (material) 2" Plastic			
(6) pump (HP) 3/4 (yield gpm) 8			
(type power) Elect			
(7) electric log (yes or no) no			
(organization running log)			
(8) how well bottom plugged Backwash valve			
DRILLERS REMARKS:			

CODED

RECEIVED
 JUL - 2 1975

If well telescopes please sketch and show depths.

GROUND LEVEL

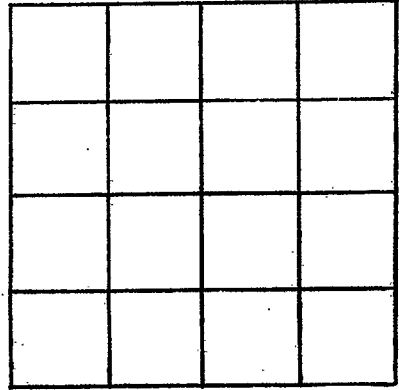

SECTION _____

Please indicate well location X.

ADDITIONAL INFORMATION

If more than one screen, show locations of each on sketch.