

Stone  
F 37  
3-24-80

MISSISSIPPI  
BOARD OF WATER COMMISSIONERS  
416 North State Street  
Jackson, Mississippi 39201

CODED

WATER WELL DRILLERS LOG

3-24-80 Griner Drilling Stone  
date well completed firm name county well located

LANDOWNER:	description of formations encountered	from	to
Mobil Oil Exploration			
Houston, Tx.	clay	0	35
(mailing address)	clay + sand	35	161
WELL LOCATION: 1559'N + 1038'W	sand	161	224
Sec. 27 T. 3 N. R. 12 E. of	sand + gravel	224	383
Wiggins, Miss. @ SE/CO			
(distance) (direction) (nearest town)			
WELL PURPOSE: oil field supply			
(home, irrigation, municipal, industrial)			
WELL COMPLETION DATA:			
(1) diameter (inches) 4"			
(2) total depth (feet) 383'			
(3) static water level (feet) 50' below top of ground.			
(4) casing steel, 315' (material) (depth)			
4" if telescope see back. (size)			
(5) screen 42' 273' (length) (depth to top)			
4" stainless steel screen (size) (material)			
(6) pump 100 (HP) (yield gpm)			
AC (type power)			
(7) electric log (yes or no)			
(organization running log)			
(8) how well bottom plugged orange			
peel			
DRILLERS REMARKS:			

CODED


DEPT. OF NATURAL RESOURCES  
BUREAU OF LAND & WATER RESOURCES

MAY 23 1980

RECEIVED

If well telescopes please sketch and show depths.

GROUND LEVEL

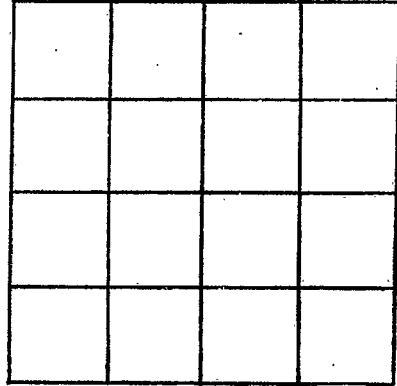

SECTION \_\_\_\_\_

Please indicate well location X.

ADDITIONAL INFORMATION

If more than one screen,  
show locations of each on sketch.