

MISSISSIPPI DEPARTMENT OF NATURAL RESOURCES

Bureau of Land and Water Resources

Southport Mall

P.O. Box 10631

Jackson, Mississippi 39209

WATER WELL DRILLERS LOG

CODED

Stone
F38
10-21-81

Griner Drilling Service, Inc.

Stone

date well completed

firm name

county well located

LANDOWNER:

Davis Oil Company
Pan Am Life Center
Suite 2091 Poydras St.
New Orleans, La 70130

description of formations encountered

from

to

sand, chalk

0 21

chalk

21 63

sand

63 189

streaked

189 273

sand, pea gravel

273 336

10' sand, gravel, 10' chalk

336 357

chalk

357 420

WELL LOCATION: 1855' N 4660' W

sec. 28 T 3 N R 12 E of

No 1 Perkinsston

IPCO (distance) miles (direction) of (nearest town)

WELL PURPOSE: oil field supply

(home, irrigation, municipal, industrial)

WELL COMPLETION DATA:

(1) diameter (inches) 4"

(2) total depth (feet) 420'

(3) static water level (feet) 65' below top of ground.

(4) casing steel 357' (material) (depth)

4" (size) if telescope see back.

(5) screen 42' 315' (length) (depth to top)

4" perforated (size) (material)

(6) pump AC (HP) 75 (yield gpm)

(7) electric log (yes or no)

(organization running log)

(8) how well bottom plugged orange

peel

DRILLERS REMARKS:

CODED


DEPT. OF NATURAL RESOURCES
BUREAU OF LAND & WATER RESOURCES

OCT 20 1981

RECEIVED

If well telescopes please sketch and show depths.

GROUND LEVEL

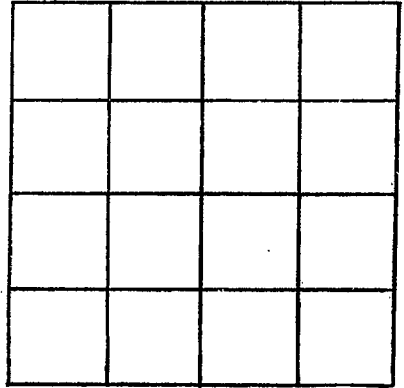

SECTION _____

Please indicate well location X.

ADDITIONAL INFORMATION

If more than one screen,
show locations of each on sketch.