
	<b>State W</b>	ell Report			
County: Store 131	F	Part 1	For Office Use Only:		
Permit #: <u>624-16017</u>	Mississippi Departmer	t of Environmental Quality	Aquifer:		
Driller: Lynan Well	4	and Water Resources Box 10631	Well #: F- 47		
01/14/05	Jackson, MS 39289-0631		L. S. Elevation:		
Date drilling completed: 01/04/05		961-5210 4 6038 (form)			
uman Well Compan	•	4-6938 (fax)	E-log #:		
State Law requires that this report be prepared by the driller in detail and filed with the Department within 30 days of completion of drilling of the well.					
Well Owner Informa	ntion	Wall	Logotion		
Owner Name MS Gulf Coast	Connunity calle	Latitude: 30 . 44 . 44	" Longitude: 89 ∘ €8 · 44 "		
Mailing Address: P.O. Box 609		Method of Lat/Long (circle one): Conventional Survey,			
		USGS quad, Hand-held	GPS, Survey-grade GPS		
PERKINSTON MS 39573 City State Zip Code		14 14 Sec_13 Twn_35 Rng_124			
City State Zip Code Telephone No. $(601)$ 928-6234		Distance Direction Nearest Town			
1 cicpiione 140, (001) 1001 40		Miles	of		
Well Data					
Purpose of Well (circle one) Home Industrial Public Supply Irrigation Fish Culture Other:					
Date well drilling started: Date well drilling completed: O1/04/05					
If flowing, method of flow regulation: Val	ve Other (d	lescribe)			
Static Water Level: <u>60</u> feet ab	pove or below (circle one)	and surface Date measured:	01/06/05		
Method of Measurement (circle one) steel tape electric tape air line other:					
Hole depth: <u>957</u> Well depth: <u>955</u> Well grouted to a depth of <u>580</u> feet					
Type of grout (circle one):	Bentonite Mix				
Casing length: <u>650</u> feet Casing diameter: <u>12</u> inches Type of casing: <u>Stee</u>					
Screen length: <u>50</u> feet Screen diameter: <u>8</u> inches Type of screen: <u>55 Wfap (ad 5</u>					
Screen slot size:OIGinches Setting depth: From905feet to955feet					
Type of completion (circle all applicable)	Type of completion (circle all applicable): Gravel packed Underreamed Telescoped Open hole Natural Development				
	Other (describe):				
Top of lap pipe or reduction in casing:					
Logs run (circle all applicable): No log ru					
Name of organization running log(s):	10EQ	accordonce with all applicable			
Department of Environmental Quality a					
		1100			
Josh Ladrer O-GO		Ucst	col		
Print Name of Water Well Contractor and	License No.	Signature of	Water WeREGEIVED		
			FEB 2 4 2005		

BY: OLWR

If well telescopes please sketch below and show depths.

• -5

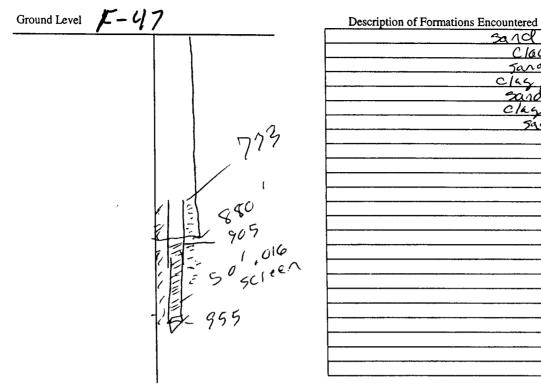

If more than one screen, show location of each on sketch

Sketch the property layout and include the following: 1) the well location; 2) any permanent structures on the property that may aid in locating the well; 3) any roads, power lines, or other items that may aid in locating the property and the well; 4) indicate direction.

Landowner Name: \_

RECEIVED FEB 2 4 2005 BY: OLWR

То

150

175

From

Styru

 $\mathcal{O}$ 

50

91

Signature of Water Well Contractor

			the contribution that a court sector	
	STATE W	ELL REPORT		
		Part 2		
County: Dane	Pump Installer's Completion Banant		For Office Use Only:	
Permit #: G-W-16017	Intrastation Department of Environmental Opality		Aquifer:	
Driller: Lynan Well	Office of Land and Water Resources P.O. Box 10631			
	Jackson, MS 39289-0631		Well # F- 47	
Date completed: 8/04/05	(601)961-5210			
		54-6938 (fax)	Blevation:	
This report should be prepared by the installation of pump.	pump installer in dete	ul and filed with the Departmen	t within 10 dama and	
Weil Owner Informatio			a within 30 days of the	
Owner Name: MS Guff Coast Connunity College		Well Location		
When Name: ITC ) Guff (ogst (og	musite College	Latitude: 30°46 44 Longitude: 88°08 44		
Mailing Address: 1.0. Box 609	• •			
		Method of Lat/Long (circle one	:): Conventional Survey,	
<u></u>		USGS guad Hand.	held CDS Summer of One	
Perkinston MS. City State	34573	USGS quad, Hand-hold GPS. Survey-grade GPS		
City State	Zip Code	1/4 Sec	Twn 32 Rng/2W	
Telephone No. (601) 928-62341		Distance Direction Nearest Town		
				Miles of
Pump Type Circle one	_	Pow	er Type	
		Cir	cle one	
ir Lift Jet	Submersible	Diesel Engine Gasoline	Engine Natural Gas	
ucket Piston	Turbine		Tratural Oas	
		Electric Motor Hand	Tráctor PTO	
entrifugal Rotary	Flowing Well	Windmill Other (s	pecify):	
ther (specify):				
		Horse Power Rating of Motor:	60	
Date Pump Installed: 4/07/05		Setting Depth:foot		
Rated Pump Capacity: 250 Gallons Per Minute		Number of Stages:		
		Nutition of Stages:		
Pump Test Data				
			uring Water Level	
ale Well Tosled: 5/04/05				
atic Water Level, (A): 60 Feet Be	elow Land Surface	Air Line Blectric Mean	uting Line Steel Tape	
<i>M</i>		Other (specify):		
amping Water Level (B):	low Land Surface			
rawdown [(B) - (A)]:40 Feet Bo	slow Land Surface	For flowing well measured -to-	t in boods	
A A A		For flowing well, measured shu	fect	
est Pumping Rate:G	allons Per Minute	Well yielded <u>800</u>	OPM with a drawdown of	
unation of Pump Test (minimum 4 hours):	24 hours		24 hours of pumping	
			hours of pumping	
HEREBY CERTIFY that the above statemer	its are true to the best o	f my knowledge A		
	)-640	The share of the		
Thi Name of Pump Installer and License No.		1 kon yoon		
Josh Ladrer	(in applicable)	Signature of Pump Ins	taller	

-----

.

Oct 27 2005 10:09AM Fax Station : MDEQ p . 1

Received Fax :

\$