STATE WELL REPORT						
County: Stone Permit #: Driller: Scott Boone Date drilling completed: 10/25/2021	Part 1 Driller's Log Mississippi Department of Environmental Quality Office of Land and Water Resources P.O. Box 2309 Jackson, MS 39225-2309		For Office Use Well #: F70 Aquifer:			
Date drilling completed:		601)961-5555		RECEIVED		
State Law requires that this report Department at the above address w	be prepared by the	mpletion of drilling of the well o	or borehole.	02-01-2022 the BY OLWF		
Well Owner Informat			hole Location			
(Landowner if borehole is not for a water well)		Latitude: 30.7654630 Longitude: -89.1568490				
Owner Name: Kerri Cooper		Method of Lat/Long (check one): Conventional Survey,				
Mailing Address: 33 One reeves ru		USGS quad, Hand-held GPS, Survey-grade GPS				
Perkinston Mississ	sipp 39573	<u>SE</u> 1⁄4 _ <u>SE</u> 1⁄4, Sec		R_12W		
City State	Zip Code	3	Perk			
Telephone No. ()		(Distance) (Direction)	(Nearest Tow	 /n)		
	Woll / B	orehole Data				
Date drilling started: 10/25/2021 Date drilling completed: 10/25/2021 Hole depth: 92 Hole diameter: 7-1/4 Location of the source of any surface water used for drilling: We • II Method of dosing and volume of Chlorine used in drilling and development: Granular						
Logs run (check <i>all applicable</i>): No log runビElectric Gamma Ray Density Sonic Neutron Other: Name of organization running log(s):						
Purpose of borehole (check one): Water Well 🗹 Geotechnical/Geological Investigation Ground Source Heat Pump						
Seism	ic Survey Other	(describe)				
	2	· · · · · · · · · · · · · · · · · · ·				
If drilling is not related to water well construction, skip the remainder of this block Purpose of Well (check all applicable): Home Industrial Public Supply Irrigation Fish Culture						
Other (describe):						
If a flowing well, method of flow regul						
Static Water Level: <u>38</u> feet [above or Delow] land surface Date measured: <u>10/25/2021</u>						
Method of measurement (check one): Well depth: <u>92</u> Well grouted to a	-					
Casing length: <u>80</u> feet Ca	asing diameter: <u>4</u>	inches Type of c	asing: PVC			
Screen length: <u>12</u> feet Screen diameter: <u>4</u> inches Type of screen: <u>PVC</u>						
Screen slot size: <u>.08</u> inches Setting depth: From <u>80</u> feet to <u>92</u> feet						
Type of completion (check all applicable): Gravel packed Underreamed Open hole Natural Development						
Other (describe):						
Top of lap pipe or reduction in casing:feet						
If telescoped or more than one screen, describe on next page						

County:	Stone
Permit #:	




For Office Use Only:

F70 Well #: _

The sketch below only required for water wells

If well telescopes, show depths on sketch.

Ground Level

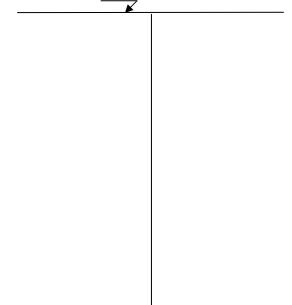

Description of formations encountered must be provided for all wells and boreholes, unless specifically exempted by regulations

Description of Formations Encountered	From (<i>depth</i>)	To (depth)
Topsoil Sand n gravel mix		3
Sand n gravel mix	3	92

If more than one screen, show location of each on sketch


Sketch the property layout and include the following:

1) the well location

2) any permanent structures on the property that may aid in locating the well

3) any roads, power lines, or other items that may aid in locating the property and the well

4) north arrow

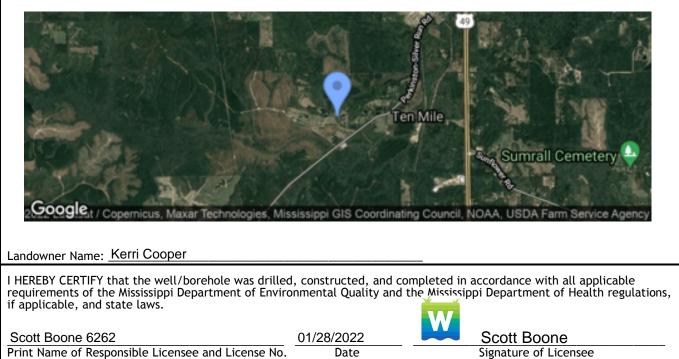

Form: OLWR-SWR-1B (4/13)