STATE WELL REPORT					
County: Stone	Mississippi Depart	Part 1 Priller's Log ment of Environmental Quality	For Office Use		
Driller: Scott Boone		and and Water Resources P.O. Box 2309	Aquifer:		
Date drilling completed: 01/09/2022	Jacks	on, MS 39225-2309 (601)961-5555	E-Log #:		
	(60	1)961-5228 (fax)	elev 180		EIVED
State Law requires that this report Department at the above address v	be prepared by the vithin 30 days of co	license holder responsible for the magnetic for the self of the se	he work and filed with or borehole.		
Well Owner Information			hole Location		LWR
(Landowner if borehole is not for a water well) Owner Name: Ronnie Rodgers		Latitude: 30.7937250 Lon	ngitude: <u>-89.159</u> 1	1150	
Mailing Address: 200 Cecil D	aniels rd	Method of Lat/Long (check one): Conventional Surve	ey,	
Mailing Address: 200 00011 D		USGS quad, Hand-held G	PS 🖌 Survey-grade	GPS	
Darle Ma		<u>SE</u> 1/4 <u>SE</u> 1/4, Sec_			
Perk Ms City State	39573 Zip Code			{	
		(Distance) Miles North (Direction)	(Nearest Tow		
Telephone No. ()			(Neurest Tow	11)	
Well / Borehole Data Date drilling started: 01/09/2022 Date drilling started: 01/09/2022 Date drilling completed: 01/09/2022 Hole depth: 100 Hole diameter: 7-1/4 Location of the source of any surface water used for drilling: Flowing stream Method of dosing and volume of Chlorine used in drilling and development: Granular					
Logs run (check <i>all applicable</i>): No log run 🗹 Electric Gamma Ray Density Sonic Neutron Other: Name of organization running log(s):					
Purpose of borehole (check one): Wate	r Well 🗹 Geotechn	ical/Geological Investigation	Ground Source Heat Pu	mp	
Seisn	nic Survey Other	(describe)			
If drilling is not rel	lated to water well c	onstruction, skip the remainder	of this block		
Purpose of Well (check all applicable): Home Industrial Public Supply Irrigation Fish Culture					
Other (describe):					
If a flowing well, method of flow regulation: Valve Other (<i>describe</i>) Static Water Level: <u>50</u> feet [above or [below] land surface Date measured: <u>01/09/2022</u>					
Method of measurement (check one): Well depth: <u>100</u> Well grouted to a					
Casing length: <u>80</u> feet C		•inches Type of c	casing: <u>PVC</u>		
Screen length: <u>20</u> feet Screen diameter: <u>4 •</u> inches Type of screen: <u>PVC</u>					
Screen slot size: <u>.08</u> inches Setting depth: From <u>80</u> feet to <u>100</u> feet					
Type of completion (check all applicable): Gravel packed Underreamed Open hole Natural Development					
Other (<i>describe</i>):					
Top of lap pipe or reduction in casing:feet If telescoped or more than one screen, describe on next page					
<u>ij</u> ielesc	open or more indit	one screen, aescrive on next pag	50		

County:	Stone	
Permit #:		
ι crime <i>π</i> .		



For	Office	Use	Only
 	F71		

The sketch below only required for water wells

If well telescopes, show depths on sketch.

×

Ground Level

Description of formations encountered must be provided for all wells and boreholes, unless specifically exempted by regulations

Well #:

Description of Formations Encountered	From (<i>depth</i>)	To (depth)
Orange gummy clay Chorus sand	Ground level	37
Chorus sand	37	100

If more than one screen, show location of each on sketch


Sketch the property layout and include the following:

1) the well location

2) any permanent structures on the property that may aid in locating the well

3) any roads, power lines, or other items that may aid in locating the property and the well

4) north arrow

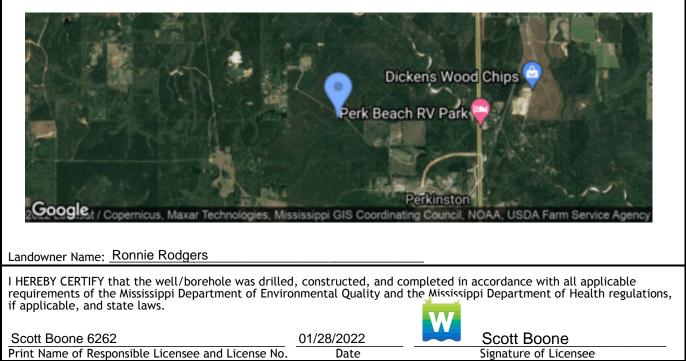

Form: OLWR-SWR-1B (4/13)