

Stone  
 F 2000  
 11/12/75

MISSISSIPPI  
 BOARD OF WATER COMMISSIONERS  
 416 North State Street  
 Jackson, Mississippi 39201

WATER WELL DRILLERS LOG


11-12 1975 Parrell Anderson Stone  
 date well completed firm name county well located

LANDOWNER:	description of formations encountered	from	to
<u>Shirley Smith</u>	<u>Top Soil</u>	<u>0</u>	<u>4</u>
(mailing address)	<u>Red clay</u>	<u>4</u>	<u>18</u>
WELL LOCATION:	<u>Coarse Sand</u>	<u>18</u>	<u>46</u>
sec <u>21</u> T <u>3</u> N R <u>12</u> E <sup>130</sup>	<u>white clay</u>	<u>46</u>	<u>78</u>
<u>4</u> miles <u>SW</u> of <u>Park</u>	<u>Fine Sand</u>	<u>78</u>	<u>87</u>
(distance) (direction) (nearest town)	<u>white clay</u>	<u>87</u>	<u>130</u>
WELL PURPOSE: <u>HOME</u>	<u>Coarse Sand</u>	<u>130</u>	<u>193</u>
(home, irrigation, municipal, industrial)			
WELL COMPLETION DATA:			
(1) diameter (inches) <u>4"</u>			
(2) total depth (feet) <u>195'</u>			
(3) static water level (feet) <u>95'</u> below top of ground.			
(4) casing <u>Plastic</u> <u>190'</u>			
(material) (depth)			
(size) if telescope see back.			
(5) screen <u>5'</u> <u>190'</u>			
(length) (depth to top)			
<u>2"</u> <u>Plastic</u>			
(size) (material)			
(6) pump <u>1</u> <u>7</u>			
(HP) (yield gpm)			
<u>Elect</u>			
(type power)			
(7) electric log <u>no</u>			
(yes or no)			
(organization running log)			
(8) how well bottom plugged <u>Back with valve</u>			
DRILLERS REMARKS:			

DISCOVER  
 MISSISSIPPI  
 DEC-4 1975

If well telescopes please sketch and show depths.

GROUND LEVEL

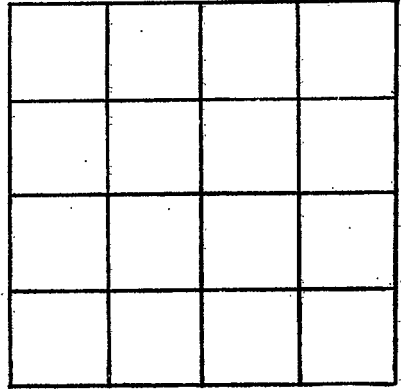

SECTION \_\_\_\_\_

Please indicate well location X.

ADDITIONAL INFORMATION

If more than one screen,  
show locations of each on sketch.