

Stone
 F 2001
 12-16-75

MISSISSIPPI
 BOARD OF WATER COMMISSIONERS
 416 North State Street
 Jackson, Mississippi 39201

WATER WELL DRILLERS LOG


12-16 1975 Small Anderson Stone
 date well completed firm name county well located

LANDOWNER:	description of formations encountered	from	to
<u>Kelby Gilmes</u>	<u>Top Soil</u>	<u>0</u>	<u>4</u>
(mailing address)	<u>Red Clay</u>	<u>4</u>	<u>28</u>
WELL LOCATION:	<u>Coarse Sand</u>	<u>28</u>	<u>108</u>
sec. <u>10</u> T. <u>3</u> S. R. <u>12</u>	<u>Clay</u>	<u>108</u>	<u>255</u>
<u>3</u> miles <u>W</u> of <u>Peck</u>	<u>Coarse Sand</u>	<u>255</u>	<u>262</u>
(distance) (direction) (nearest town)			
WELL PURPOSE: <u>HOME</u> (home, irrigation, municipal, industrial)			
WELL COMPLETION DATA:			
(1) diameter (inches) <u>2"</u>			
(2) total depth (feet) <u>262'</u>			
(3) static water level (feet) <u>108</u> below top of ground.			
(4) casing <u>Plastic</u> , <u>257'</u> (material) (depth)			
(size) If telescope see back.			
(5) screen <u>5'</u> , <u>257'</u> (length) (depth to top)			
<u>2"</u> , <u>Plastic</u> (size) (material)			
(6) pump <u>1</u> , <u>3-1/2</u> (HP) (yield gpm)			
<u>Elect</u> (type power)			
(7) electric log <u>no</u> (yes or no)			
(organization running log)			
(8) how well bottom plugged <u>Back with Water</u>			
DRILLERS REMARKS:			

DEPARTMENT OF WATER CONTROL
 JAN 5 1976

If well telescopes please sketch and show depths.

GROUND LEVEL

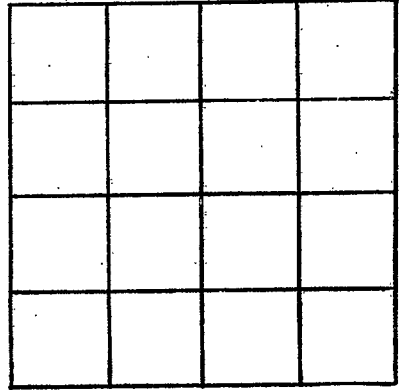

SECTION _____

Please indicate well location X.

ADDITIONAL INFORMATION

If more than one screen, show locations of each on sketch.