

Stone
 F2004
 10/7/76

MISSISSIPPI
 BOARD OF WATER COMMISSIONERS
 416 North State Street
 Jackson, Mississippi 39201

WATER WELL DRILLERS LOG

10-7
 date well completed

1976 *Farrell Anderson*
 firm name

Stone
 county well located

LANDOWNER:
Mike Beckum
 (mailing address)

WELL LOCATION:
 sec *32* T *3* R *12*
4 1/2 miles *SW* of *Park*
 (distance) (direction) (nearest town)

WELL PURPOSE: *HOME*
 (home, irrigation, municipal, industrial)

- WELL COMPLETION DATA:
- (1) diameter (inches) *2"*
 - (2) total depth (feet) *105'*
 - (3) static water level (feet) *56* below top of ground
 - (4) casing *Plastic, 100'*
 (material) (depth)
 (size) if telescope see back.
 - (5) screen *5" 100'*
 (length) (depth to top)
2" Plastic
 (size) (material)
 - (6) pump *1* *9*
 (HP) (yield gpm)
Elect
 (type power)
 - (7) electric log *no*
 (yes or no)
- (organization running log)
- (8) how well bottom plugged
Capped

description of formations encountered	from	to
<i>Top Soil</i>	<i>0</i>	<i>2</i>
<i>Fine Sand</i>	<i>2</i>	<i>18</i>
<i>Blue Clay</i>	<i>18</i>	<i>44</i>
<i>Coarse Sand</i>	<i>44</i>	<i>85</i>
<i>Fin Sand</i>	<i>85</i>	<i>92</i>
<i>Coarse Sand</i>	<i>92</i>	<i>105</i>


RECEIVED
 NOV - 4 1976

MISS. BD. OF WATER COMMISSIONERS

DRILLERS REMARKS:

If well telescopes please sketch and show depths.

GROUND LEVEL

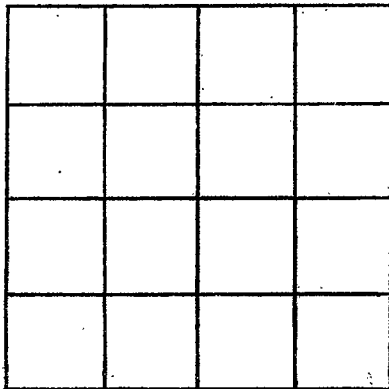

SECTION _____

Please indicate well location X.

ADDITIONAL INFORMATION

If more than one screen, show locations of each on sketch.