

Stone
 F 2005
 10/8/76

MISSISSIPPI
 BOARD OF WATER COMMISSIONERS
 416 North State Street
 Jackson, Mississippi 39201

WATER WELL DRILLERS LOG

10-8 1976 ¹³⁰ *Parrell Anderson Stone*
 date well completed firm name county well located


LANDOWNER:	description of formations encountered	from	to
<i>Vincent Trochet</i>	<i>Top Soil</i>	0	3
(mailing address)	<i>Course Sand</i>	3	37
WELL LOCATION:	<i>Clay</i>	37	38
sec. <i>24</i> T. <i>3</i> S. R. <i>12</i> E.	<i>Fin. Sand</i>	38	68
1 miles S of <i>Peak</i>	<i>Course Sand</i>	68	85
WELL PURPOSE: <i>HOME</i> (home, irrigation, municipal, industrial)			
WELL COMPLETION DATA:			
(1) diameter (inches) <i>2"</i>			
(2) total depth (feet) <i>85-</i>			
(3) static water level (feet) <i>9'</i> below above top of ground.			
(4) casing <i>Plastic 80'</i> (material) (depth)			
(size) If telescope see back.			
(5) screen <i>5" 80'</i> (length) (depth to top)			
<i>2" Plastic</i> (size) (material)			
(6) pump <i>1</i> <i>11</i> (HP) (yield gpm)			
<i>Electric</i> (type power)			
(7) electric log <i>no</i> (yes or no)			
(organization running log)			
(8) how well bottom plugged <i>Capped</i>			
DRILLERS REMARKS:			

RECEIVED
 NOV - 4 1976

MISS. RD. OF WATER COMMISSIONERS

If well telescopes please sketch and show depths.

GROUND LEVEL.

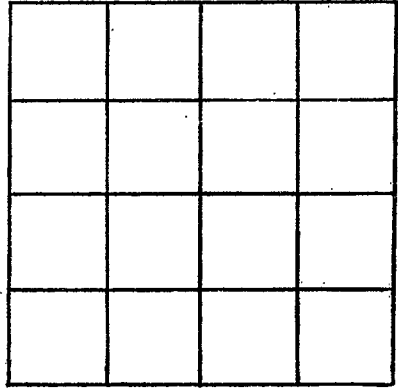

SECTION _____

Please indicate well location X.

ADDITIONAL INFORMATION

If more than one screen, show locations of each on sketch.