

Stone
 F 2000
 11/22/76

MISSISSIPPI
 BOARD OF WATER COMMISSIONERS
 416 North State Street
 Jackson, Mississippi 39201

13a

WATER WELL DRILLERS LOG

11-22 1976 Parrell Anderson Stone
 date well completed firm name county well located

LANDOWNER:
Clarence Lilnes
 (mailing address)

description of formations encountered	from	to
Top Soil	0	3
Red Clay	3	18
Course Sand	18	82
Clay	82	111
Sand	111	146
Clay	146	210
Course Sand	210	230

WELL LOCATION:
 sec. 10 T 3 R 12
3 1/4 miles W of Perk
 (distance) (direction) (nearest town)

WELL PURPOSE: HOME
 (home, irrigation, municipal, industrial)

WELL COMPLETION DATA:

(1) diameter (inches) 2"

(2) total depth (feet) 230'

(3) static water level (feet) 100' below top of ground.

(4) casing Plastic 225' (material) (depth)
 (size) If telescope see back.

(5) screen 3" (length) 225' (depth to top)
2" (size) Plastic (material)

(6) pump 1 (HP) 6 (yield gpm)
Elect (type power)

(7) electric log no (yes or no)
 (organization running log)

(8) how well bottom plugged Capped


DRILLERS REMARKS:

RECEIVED
 DEC 10 1976

MISS. WATER COMMISSION

If well telescopes please sketch and show depths.

GROUND LEVEL

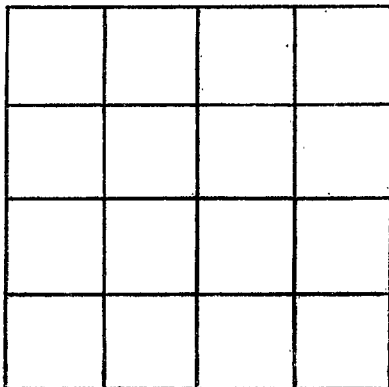

SECTION _____

Please indicate well location X.

ADDITIONAL INFORMATION

If more than one screen,
show locations of each on sketch.