

Stone
 F 2007
 4-5-77

MISSISSIPPI
 BOARD OF WATER COMMISSIONERS
 416 North State Street
 13a Jackson, Mississippi 39201

WATER WELL DRILLERS LOG


4-5 1977 Darnell Anderson Stone
 date well completed firm name county well located

LANDOWNER:	description of formations encountered	from	to
Tom Bankston	Top Soil	0	2
(mailing address)	Red Clay	2	14
WELL LOCATION: sec. <u>23</u> T. <u>3</u> S. R. <u>12</u> E. <u>1 1/2</u> miles SW of <u>Peuk</u> (distance) (direction) (nearest town)	Fine Sand	14	42
WELL PURPOSE: <u>HOME</u> (home, irrigation, municipal, industrial)			
WELL COMPLETION DATA: (1) diameter (inches) <u>8"</u> (2) total depth (feet) <u>42'</u> (3) static water level (feet) <u>29'</u> below above top of ground. (4) casing <u>Plastic</u> , <u>37'</u> (material) (depth) (size) if telescope see back. (5) screen <u>15"</u> , <u>37'</u> (length) (depth to top) <u>2"</u> , <u>Plastic</u> (size) (material) (6) pump <u>1</u> (HP) <u>6</u> (yield gpm) <u>E Vest</u> (type power) (7) electric log <u>No</u> (yes or no) (organization running log)			
DRILLERS REMARKS: <u>Capped</u>			

RECEIVED
 MAY 9 1977

If well telescopes please sketch and show depths.

GROUND LEVEL

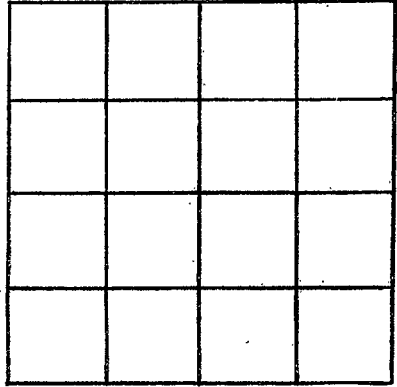

SECTION _____

Please indicate well location X.

ADDITIONAL INFORMATION

If more than one screen, show locations of each on sketch.