

Stone  
 F 2008  
 5-9-77

MISSISSIPPI  
 BOARD OF WATER COMMISSIONERS  
 416 North State Street  
 132 Jackson, Mississippi 39201

WATER WELL DRILLERS LOG

5-9 date well completed 1977 firm name *Parnell Anderson Stone* Stone county well located


LANDOWNER:	description of formations encountered	from	to
<i>Ed Dates</i>  (mailing address)	<i>Top Soil</i>	<i>0</i>	<i>2</i>
	<i>Blue Clay</i>	<i>2</i>	<i>18</i>
WELL LOCATION: sec. <i>26</i> T. <i>3</i> N. R. <i>12</i> W. S. <i>5</i> <i>2</i> miles <i>S</i> of <i>Park</i> (distance) (direction) (nearest town)	<i>Course Sand</i>	<i>18</i>	<i>10</i>
WELL PURPOSE: <i>HOME</i> (home, irrigation, municipal, industrial)			
WELL COMPLETION DATA:			
(1) diameter (inches) <i>3"</i>			
(2) total depth (feet) <i>105'</i>			
(3) static water level (feet) <i>38'</i> below top of ground.			
(4) casing (material) <i>Plastic</i> , (depth) <i>100'</i> (size) If telescope see back.			
(5) screen (length) <i>5'</i> , (depth to top) <i>100'</i> <i>2"</i> (size), <i>Plastic</i> (material)			
(6) pump (HP) <i>1</i> , (yield gpm) <i>10</i> <i>E. East</i> (type power)			
(7) electric log <i>no</i> (yes or no)			
(organization running log)			
(8) how well bottom plugged <i>cap</i>			
DRILLERS REMARKS:			

RECEIVED  
 JUN 13 1977

MISS. Bd. of Water Comm.

If well telescopes please sketch and show depths.

GROUND LEVEL

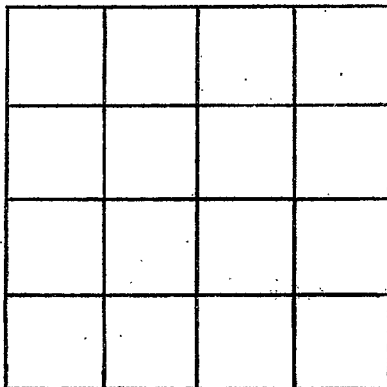

SECTION \_\_\_\_\_

Please indicate well location X.

ADDITIONAL INFORMATION

If more than one screen, show locations of each on sketch.