

STONE

F 2009

5/11/77

MISSISSIPPI
BOARD OF WATER COMMISSIONERS

416 North State Street

132 Jackson, Mississippi 39201

WATER WELL DRILLERS LOG

5-11
date well completed

1977 *Samuel Anderson*
firm name

Stone
county well located

LANDOWNER: *Chester Scarborough*
(mailing address)

WELL LOCATION:
sec. 3 T. 3 R. 12
4 miles NW of Perk
(distance) (direction) (nearest town)

WELL PURPOSE: HOME
(home, irrigation, municipal, industrial)

WELL COMPLETION DATA:
(1) diameter (inches) 2"
(2) total depth (feet) 171
(3) static water level (feet) 73 below above
top of ground.
(4) casing Plastic, 166'
(material) (depth)
(size) If telescope see back.
(5) screen 5' 166'
(length) (depth to top)
3" Plastic
(size) (material)
(6) pump 1 8
(HP) (yield gpm)
Elect
(type power)
(7) electric log no
(yes or no)
(organization running log)
(8) how well bottom plugged Barbed wire valve

| description of formations encountered | from | to |
|---------------------------------------|------------|------------|
| <i>Top soil</i> | <i>0</i> | <i>2</i> |
| <i>Sand</i> | <i>2</i> | <i>88"</i> |
| <i>Clay</i> | <i>88</i> | <i>131</i> |
| <i>Hard Sand</i> | <i>131</i> | <i>160</i> |
| <i>Course Sand</i> | <i>160</i> | <i>171</i> |


RECEIVED
JUN 13 1977

DRILLERS REMARKS:

MISSISSIPPI BOARD OF WATER COMMISSIONERS

If well telescopes please sketch and show depths.

GROUND LEVEL

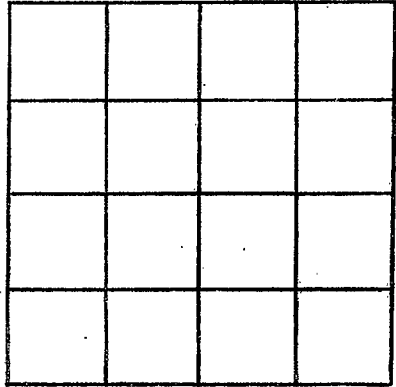

SECTION _____

Please indicate well location X.

ADDITIONAL INFORMATION

If more than one screen,
show locations of each on sketch.