

Stone  
F 2001  
12/13/77

MISSISSIPPI  
BOARD OF WATER COMMISSIONERS  
416 North State Street  
Jackson, Mississippi 39201

WATER WELL DRILLERS LOG

12-13 1977 *Parnell Anderson* *Stone*  
date well completed firm name county well located

LANDOWNER: *A. L. Spies*  
description of formations encountered: *Top Soil* from 0 to *2*  
*Coarse Sand* 2 to *35*  
(mailing address)

WELL LOCATION:  
sec. *14* T. *3* N. R. *12* E.  
*13* miles *W* of *Peuk*  
(distance) (direction) (nearest town)

WELL PURPOSE: *HOME*  
(home, irrigation, municipal, industrial)


WELL COMPLETION DATA:  
(1) diameter (inches) *2*  
(2) total depth (feet) *35*  
(3) static water level (feet) *18* below top of ground.  
(4) casing *Plastic*, *30'*  
(material) (depth)  
(size) if telescope see back.  
(5) screen *5'*, *30'*  
(length) (depth to top)  
*2"*, *Plastic*  
(size) (material)  
(6) pump *1*, *9*  
(HP) (yield gpm)  
*Elect*  
(type power)  
(7) electric log *no*  
(yes or no)  
(organization running log)  
(8) how well bottom plugged *Capped*

RECEIVED  
JAN - 4 1978

DRILLERS REMARKS:  
MISS. BD. OF WATER COMMISSIONERS

If well telescopes please sketch and show depths.

GROUND LEVEL

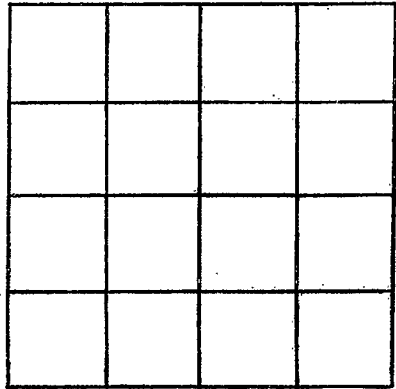

SECTION \_\_\_\_\_

Please indicate well location X.

ADDITIONAL INFORMATION

If more than one screen, show locations of each on sketch.