

Stone
F 208
Z-4-80

MISSISSIPPI
BOARD OF WATER COMMISSIONERS
416 North State Street
Jackson, Mississippi 39201

WATER WELL DRILLERS LOG

2-7 1980
date well completed

80 *Arnold Anderson*
firm name

Stems
county well located

LANDOWNER:	description of formations encountered	from	to
<i>Lyn Gay</i>	<i>Topsoil</i>	0	2
(mailing address)	<i>Cooper Road</i>	2	89
WELL LOCATION:			
sec <u>13</u> T <u>3</u> N R <u>13</u> E S			
<i>In town</i> miles _____ of <i>Park</i> (distance) (direction) (nearest town)			
WELL PURPOSE: <i>HOMIE</i> (home, irrigation, municipal, industrial)			
WELL COMPLETION DATA:			
(1) diameter (inches) <u>2"</u>			
(2) total depth (feet) <u>85'</u>			
(3) static water level (feet) <u>10'</u> below top of ground. above			
(4) casing <u>Plastic</u> , <u>80'</u> (material) (depth)			
_____ If telescope see back. (size)			
(5) screen <u>5'</u> , <u>80'</u> (length) (depth to top)			
<u>3"</u> , <u>Plastic</u> (size) (material)			
(6) pump <u>1</u> <u>12</u> (HP) (yield gpm)			
<u>Elect</u> (type power)			
(7) electric log <u>no</u> (yes or no)			
_____ (organization running log)			
(8) how well bottom plugged <u>Cap</u>			
DRILLERS REMARKS:			


DEPT. OF NATURAL RESOURCES
BUREAU OF LAND & WATER RESOURCES

MAR 10 1980

RECEIVED

If well telescopes please sketch and show depths.

GROUND LEVEL

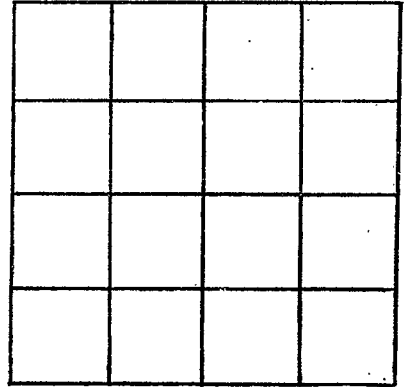

SECTION _____

Please indicate well location X.

ADDITIONAL INFORMATION

If more than one screen, show locations of each on sketch.