

Shark

F 200A

5-2-80

MISSISSIPPI  
 BOARD OF WATER COMMISSIONERS  
 416 North State Street  
 Jackson, Mississippi 39201

WATER WELL DRILLERS LOG

5-2 1980 Braden Pump & Well Stone  
 date well completed firm name county well located

LANDOWNER: Edward Hart Ried description of formations encountered from to  
 P.O. Box 86  
 Perkinston, MS clay 0 100  
 (mailing address) sand 160 160

WELL LOCATION:  
 7 sec. 11 T. 3 S R. 12 W  
 6 1/2 miles N of Perkerkinston  
 (distance) (direction) (nearest town)

WELL PURPOSE: home  
 (home, irrigation, municipal, industrial)

- WELL COMPLETION DATA:
- (1) diameter (inches) 2"
  - (2) total depth (feet) 160'
  - (3) static water level (feet) 50 below top of ground.
  - (4) casing PVC, total (material), (depth)  
 2" (size) If telescope see back.
  - (5) screen 10', 150' (length) (depth to top)  
 2" (size), mosaic underbar (material)
  - (6) pump 1 (HP) 10 (yield gpm)  
 230 (type power)
  - (7) electric log NO (yes or no)
- (organization running log)

(8) how well bottom plugged:  
 2" sand shark

DRILLERS REMARKS:  
 No tail pipe


DEPT. OF NATURAL RESOURCES  
 BUREAU OF LAND & WATER RESOURCES

JUN 25 1980

RECEIVED

If well telescopes please sketch and show depths.

GROUND LEVEL

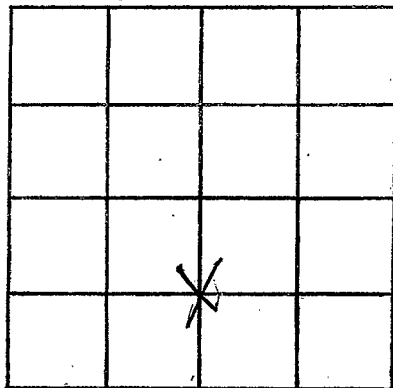

SECTION 11

Please indicate well location X.

ADDITIONAL INFORMATION

If more than one screen,  
show locations of each on sketch.