

Stone
F 2000
5-20-80

MISSISSIPPI
BOARD OF WATER COMMISSIONERS
416 North State Street
Jackson, Mississippi 39201

WATER WELL DRILLERS LOG

5-20
date well completed

1980 Parrell Anderson
firm name


Stone
county well located

LANDOWNER:	description of formations encountered	from	to
<u>C. J. Beacom</u>	<u>Top Soil</u>	<u>0</u>	<u>2</u>
(mailing address)	<u>Red clay</u>	<u>2</u>	<u>27</u>
WELL LOCATION:	<u>Conner Road</u>	<u>2</u>	<u>68</u>
sec <u>23</u> T <u>3</u> N R <u>12</u>			
<u>1/2</u> miles <u>W</u> of <u>Darb</u>			
(distance) (direction) (nearest town)			
WELL PURPOSE: <u>HOME</u> (home, irrigation, municipal, industrial)			
WELL COMPLETION DATA:			
(1) diameter (inches) <u>2</u>			
(2) total depth (feet) <u>68</u>			
(3) static water level (feet) <u>6</u> below top of ground			
(4) casing <u>Plastic</u> , <u>63'</u> (material) (depth)			
(size) If telescope see back.			
(5) screen <u>5'</u> , <u>63'</u> (length) (depth to top)			
<u>2"</u> , <u>Plastic</u> (size) (material)			
(6) pump <u>1</u> , <u>13</u> (HP) (yield gpm)			
<u>Elect</u> (type power)			
(7) electric log <u>No</u> (yes or no)			
(organization running log)			
(8) how well bottom plugged <u>Capped</u>			
DRILLERS REMARKS:			

DEPT. OF NATURAL RESOURCES
BUREAU OF LAND & WATER RESOURCES
JUN 4 1980
RECEIVED

If well telescopes please sketch and show depths.

GROUND LEVEL

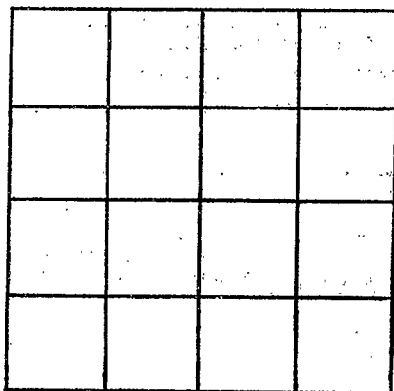

SECTION _____

Please indicate well location X.

ADDITIONAL INFORMATION

BLW DEPT
10/12/2006

If more than one screen, show locations of each on sketch.