

Stone
F 2000
8/22/80

MISSISSIPPI
BOARD OF WATER COMMISSIONERS
416 North State Street
Jackson, Mississippi 39201

WATER WELL DRILLERS LOG

stone

8/22/80 19 Lyman Well Co. ~~Harrison~~
date well completed firm name county well located

LANDOWNER: Dusy Beland
McBryen & Partison
W
(mailing address)

description of formations encountered	from	to
yellow clay	0	10
red sand & gravel	10	45
yellow & white clay	45	86
green clay	86	134
yellow sand	134	150

WELL LOCATION:
sec. 10 T. 4 S. R. 12 E.
3 miles (distance) W of Perkingston (direction) (nearest town)

WELL PURPOSE: home
(home, irrigation, municipal, industrial)

WELL COMPLETION DATA:

- diameter (inches) 2
- total depth (feet) 150'
- static water level (feet) 43 below above top of ground.
- casing PVC 140'
(material) (depth)
2"
(size) if telescope see back.
- screen 10' 140'
(length) (depth to top)
6 slot PVC
(size) (material)
- pump 1 1/2
(HP) (yield gpm)
electric
(type-power)
- electric log No
(yes or no)
- how well bottom plugged sand
shark

DRILLERS REMARKS:


DEPT. OF NATURAL RESOURCES
BUREAU OF LAND & WATER RESOURCES

NOV 6 1980

RECEIVED

If well telescopes please sketch and show depths.

GROUND LEVEL

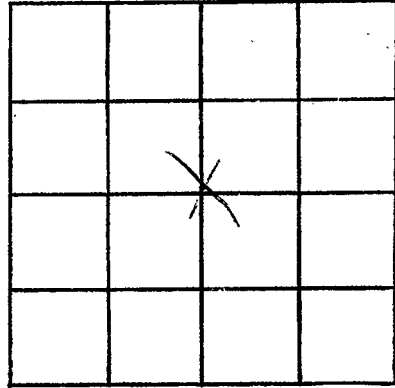

SECTION 10

Please indicate well location X.

ADDITIONAL INFORMATION

If more than one screen, show locations of each on sketch.