

STONE
F 2022

MISSISSIPPI
BOARD OF WATER COMMISSIONERS
416 North State Street
Jackson, Mississippi 39201

9-25-80

WATER WELL DRILLERS LOG

9-25-1980
date well completed

80 Parnell Anderson
firm name

Stone
county well located

LANDOWNER: A. L. Leaks

description of formations encountered

from to

Plt 2

Tap Hole

0 3

Clay

3 20

Sand

22 30

Clay

30 34

Coarse Sand

34 45

Durbinston MS 39573
(mailing address)

WELL LOCATION:

33 sec. T 3 R 12 E
135 miles E-W of Perb
(distance) (direction) (nearest town)

WELL PURPOSE:

(home, irrigation, municipal, industrial)

WELL COMPLETION DATA:

(1) diameter (inches) 4 1/2" 2"

(2) total depth (feet) 45'

(3) static water level (feet) 15' below above top of ground.

(4) casing Plastic 40"
(material) (depth)

2" if telescope see back.
(size)

(5) screen 5' 40'
(length) (depth to top)

2" Plastic
(size) (material)

(6) pump 1 12
(HP) (yield gpm)

Electric
(type power)

(7) electric log NO
(yes or no)


(organization running log)

(8) how well bottom plugged Capped

DRILLERS REMARKS:

If well telescopes please
sketch and show depths.

GROUND LEVEL

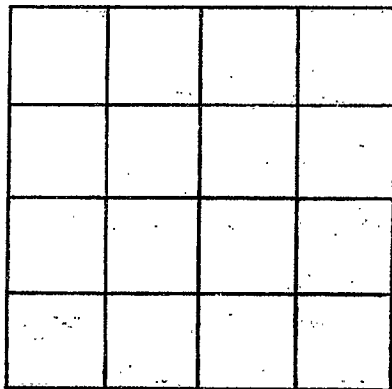

SECTION _____

Please indicate well location X.

ADDITIONAL INFORMATION

If more than one screen,
show locations of each on sketch.