

MISSISSIPPI DEPARTMENT OF NATURAL RESOURCES

Bureau of Land and Water Resources

Southport Mall

P.O. Box 10631

Jackson, Mississippi 39209

WATER WELL DRILLERS LOG

Stone
F
2003

3-8 date well completed

Frank Pucip firm name

Stone county well located

LANDOWNER:
Russel Boone
(mailing address)

description of formations encountered	from	to
Top Soil	0	3
Clay	3	26
Fine Sand	26	62
Coarse Sand	62	88

WELL LOCATION:
sec. 14 T. 3 S. R. 12 E
1 1/2 miles W of Perk
(distance) (direction) (nearest town)

WELL PURPOSE: HOME
(home, irrigation, municipal, industrial)

WELL COMPLETION DATA:

(1) diameter (inches) 2"

(2) total depth (feet) 88'

(3) static water level (feet) 60' below top of ground.

(4) casing (material) Plastic, (depth) 80'

(size) if telescope see back.

(5) screen 5' length, 80' depth to top
2" (size), Plastic (material)

(6) pump 1 (HP), 10 (yield gpm)
Elect (type power)

(7) electric log No (yes or no)

(organization running log)

(8) how well bottom plugged capped

DRILLERS REMARKS:


DEPT. OF NATURAL RESOURCES
BUREAU OF LAND & WATER RESOURCES

APR - 2 1902

RECEIVED

If well telescopes please sketch and show depths.

GROUND LEVEL

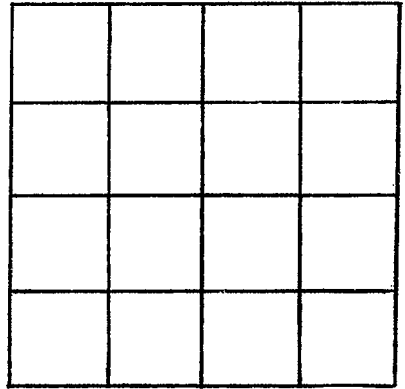

SECTION _____

Please indicate well location X.

ADDITIONAL INFORMATION

If more than one screen,
show locations of each on sketch.