

MISSISSIPPI DEPARTMENT OF NATURAL RESOURCES

Bureau of Land and Water Resources

Southport Mall

P.O. Box 10631

Jackson, Mississippi 39209

WATER WELL DRILLERS LOG

Stone
F
2024

4-14-82

Greiner Drilling Service, Inc. Stone

date well completed

firm name

county well located


LANDOWNER:	description of formations encountered	from	to
R. E. Williams P.O. Box 698 Natchez, MS. 39120 (mailing address)			
WELL LOCATION: 1576' N + 1712' W N 27° 3' T 3 N R 12 E S 1/4 or IPCO Perkingston (distance) miles (direction) of (nearest town)			
WELL PURPOSE: oil field supply (home, irrigation, municipal, industrial)			
WELL COMPLETION DATA:			
(1) diameter (inches) 3"			
(2) total depth (feet) 350'			
(3) static water level (feet) 50' below top of ground.			
(4) casing steel 336ft (material) (depth) 3" (size) if telescope see back.			
(5) screen 42' 294' (length) (depth to top) 3" perforated (size) (material)			
(6) pump 80 (HP) (yield gpm) ac (type power)			
(7) electric log (yes or no) (organization running log)			
(8) how well bottom plugged orange peel			
DRILLERS REMARKS:			

DEPT. OF NATURAL RESOURCES  
BUREAU OF LAND & WATER RESOURCES

MAY -5 1982  
RECEIVED

If well telescopes please sketch and show depths.

GROUND LEVEL

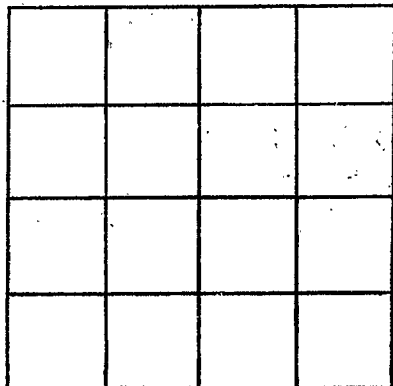

SECTION \_\_\_\_\_

Please indicate well location X.

ADDITIONAL INFORMATION

If more than one screen, show locations of each on sketch.