

Stone  
 K 2005

MISSISSIPPI  
 BOARD OF WATER COMMISSIONERS  
 416 North State Street  
 Jackson, Mississippi 39201

WATER WELL DRILLERS LOG

May 12 1982 Parnee Anderson Stone  
 date well completed firm name county well located

LANDOWNER: Wesley Mills	description of formations encountered	from	to
Route	Top soil	0	2
Wiggins Ms (mailing address)	Clay	2	19
WELL LOCATION:	Sand	19	24
sec. 4 T 3 R 12 S W	Clay	24	76
8 miles W of Wiggins	Sand	76	89
(distance) (direction) (nearest town)			
WELL PURPOSE: Home (home, irrigation, municipal, industrial)			
WELL COMPLETION DATA:			
(1) diameter (inches) 2"			
(2) total depth (feet) 89'			
(3) static water level (feet) 40' below top of ground.			
(4) casing PVC (material) (depth)			
(size) If telescope see back.			
(5) screen 5' 84' (length) (depth to top)			
2" PVC (size) (material)			
(6) pump 1 HP 12 (yield gpm)			
Electric (type power)			
(7) electric log NO (yes or no)			
(organization running log)			
(8) how well bottom plugged Copper			

DRILLERS REMARKS:


DEPT. OF NATURAL RESOURCES  
 BUREAU OF LAND & WATER RESOURCES

JUN - 9 1982

RECEIVED

If well telescopes please sketch and show depths.

GROUND LEVEL

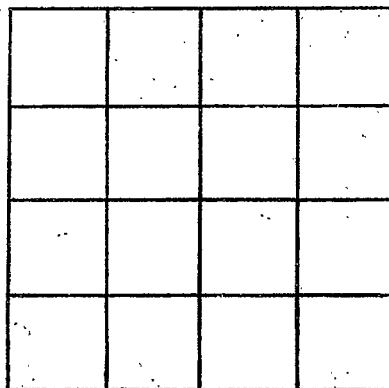

SECTION \_\_\_\_\_

Please indicate well location X.

ADDITIONAL INFORMATION

If more than one screen,  
show locations of each on sketch.