

MISSISSIPPI DEPARTMENT OF NATURAL RESOURCES

Bureau of Land and Water Resources

Southport Mall

P.O. Box 10631

Jackson, Mississippi 39209

WATER WELL DRILLERS LOG

Stone
F
2027

10-11-19 date well completed

82 Frank Price firm name

Stone county well located

LANDOWNER:

Tom Bankston

(mailing address)

WELL LOCATION:

sec. 23 T-3 R-12 E
 1 miles S W of Perk
 (distance) (direction) (nearest town)

WELL PURPOSE: HOME
 (home, irrigation, municipal, industrial)

WELL COMPLETION DATA:

- (1) diameter (inches) 2"
- (2) total depth (feet) 48'
- (3) static water level (feet) 25' below top of ground.
- (4) casing Plastic, 43' (material) (depth)
- (5) screen 3' 43' (length) (depth to top)
 2" Plastic (size) (material)
- (6) pump 1 10 (HP) (yield gpm)
 Elect (type power)
- (7) electric log No (yes or no)

(organization running log)

(8) how well bottom plugged Back with valves

DRILLERS REMARKS:

description of formations encountered

from to

Top Soil	0	2'
Red Clay	2'	15'
Coarse Sand	15'	48'


MISSISSIPPI DEPT. OF NATURAL RESOURCES
 BUREAU OF LAND & WATER RESOURCES

NOV - 4 1982

RECEIVED

If well telescopes please sketch and show depths.

GROUND LEVEL

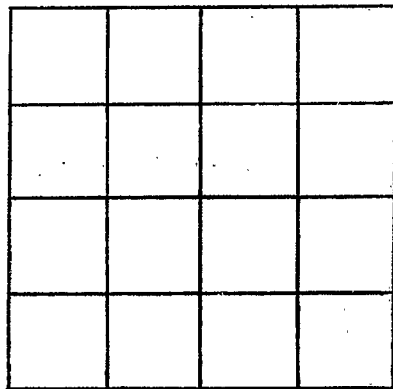

SECTION _____

Please indicate well location X.

ADDITIONAL INFORMATION

If more than one screen,
show locations of each on sketch.