

MISSISSIPPI DEPARTMENT OF NATURAL RESOURCES

Bureau of Land and Water Resources

Southport Mall

P.O. Box 10631

Jackson, Mississippi 39209

WATER WELL DRILLERS LOG

STONE
F 2031

8-28
date well completed

1984 Frank Price
firm name

Stone
county well located

LANDOWNER:
Olen Parker

(mailing address)

WELL LOCATION:
sec. 26 T 3 S R 12 W
1 miles S of Park
(distance) (direction) (nearest town)

description of formations encountered	from	to
<u>Top Soil</u>	<u>0</u>	<u>2</u>
<u>Clay</u>	<u>2</u>	<u>65</u>
<u>Fine Sand</u>	<u>65</u>	<u>75</u>
<u>Coarse Sand</u>	<u>75</u>	<u>83</u>

WELL PURPOSE: HOMES
(home, irrigation, municipal, industrial)

WELL COMPLETION DATA:

(1) diameter (inches) 2"

(2) total depth (feet) 83'

(3) static water level (feet) 30 below top of ground. above

(4) casing PVC (material), 78' (depth)

_____ If telescope see back. (size)

(5) screen 5' (length), 78' (depth to top)

2" (size), PVC (material)

(6) pump 1 (HP), 10 (yield gpm)

Elect (type power)

(7) electric log no (yes or no)

_____ (organization running log)

(8) how well bottom plugged B W V


DRILLERS REMARKS:

DEPT. OF NATURAL RESOURCES
BUREAU OF LAND & WATER RESOURCES

SEP - 7 1984
RECEIVED

If well telescopes please sketch and show depths.

GROUND LEVEL

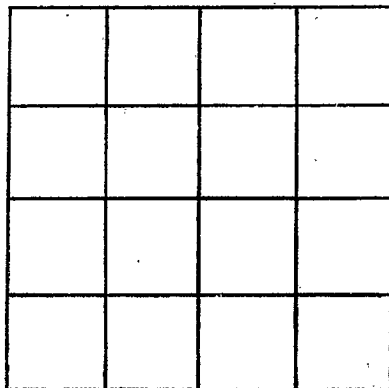

SECTION _____

Please indicate well location X.

ADDITIONAL INFORMATION

If more than one screen,
show locations of each on sketch.