

MISSISSIPPI DEPARTMENT OF NATURAL RESOURCES

Bureau of Land and Water Resources

Southport Mall

P.O. Box 10631

Jackson, Mississippi 39209

WATER WELL DRILLERS LOG

F 2032
STONE
3-14-85

3-14
date well completed

1985 - Iron Pipe
firm name

Stone
county well located

LANDOWNER:
John Pickett

(mailing address)

WELL LOCATION:
sec. 18 T. 3 S. R. 12 E.
1/4 miles N of Boone
(distance) (direction) (nearest town)

WELL PURPOSE: HOME
(home, irrigation, municipal, industrial)

WELL COMPLETION DATA:

(1) diameter (inches) 2"

(2) total depth (feet) 85'

(3) static water level (feet) 50' below above top of ground.

(4) casing PVC 80'
(material) (depth)

(size) if telescope see back.

(5) screen 5' 80'
(length) (depth to top)

2" PVC
(size) (material)

(6) pump 1 9
(HP) (yield gpm)

Elect
(type power)

(7) electric log no
(yes or no)

(organization running log)

(8) how well bottom plugged BWV

description of formations encountered	from	to
<u>Top Soil</u>	<u>0</u>	<u>3</u>
<u>Sandy clay</u>	<u>3</u>	<u>20</u>
<u>fine sand</u>	<u>20</u>	<u>80</u>
<u>Course sand</u>	<u>80</u>	<u>85</u>


RECEIVED
APR 17 1985

Department of Natural Resources
Bureau of Land & Water Resources

DRILLERS REMARKS:

If well telescopes please sketch and show depths.

GROUND LEVEL

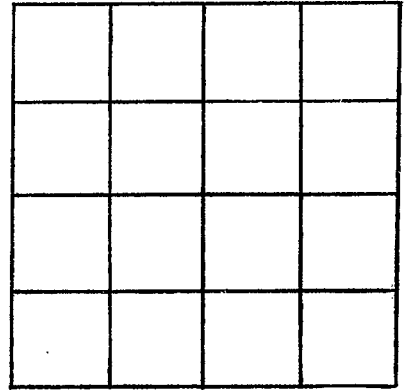

SECTION _____

Please indicate well location X.

ADDITIONAL INFORMATION

If more than one screen, show locations of each on sketch.