

MISSISSIPPI DEPARTMENT OF ENVIRONMENTAL QUALITY

Office of Land and Water Resources

COUNTY WELL LOCATED Stone	
WELL NUMBER F-2045	CODED
DATE WELL COMPLETED 10-25-00	

PERMIT NUMBER
NAME OF DRILLING FIRM Moore's Water Well Service
31 R. Moore Rd Wiggins

P. O. Box 10631
Jackson, MS 39289-0631
WATER WELL DRILLERS LOG

NAME & MAILING ADDRESS OF LANDOWNER Charlie Yelverton 206 Banks ton Rd Perkingston MS		
WELL LOCATION: SEC	TOWNSHIP	RANGE
23	S	12 W
DISTANCE	DIRECTION	NEAREST TOWN
4 Miles	West of	Perkingston
OTHER LANDMARK		
WELL PURPOSE: <input checked="" type="checkbox"/> Home, <input type="checkbox"/> Irrigation, <input type="checkbox"/> Municipal, <input type="checkbox"/> Industrial, <input type="checkbox"/> Fish Pond, etc.		

PUMP DATA		
PUMP TYPE (Circle One): Submersible, Turbine, <input checked="" type="radio"/> Jet, Flowing Well, Other (Describe) _____		
POWER TYPE (Circle One): <input checked="" type="radio"/> Electric, Tractor, Diesel, Gasoline, Butane, Other (Describe) _____ H/P _____		
Pump Capacity (GPM) 6	No. of Stages 2	Setting Depth _____ FT.
PUMP TEST		
Well yielded _____ GPM with a drawdown of _____ ft. after _____ hours of pumping		

WELL DATA		
Well Depth 119'	Casing Diameter (In.) 2"	Casing Length (Ft.) 109'
Type of Casing PVC	Hole Depth 119'	Depth to Static Water Level 79'

LOG DATA			
TYPE OF LOG RUN (Circle One): No Log Run, Electric, Gamma Ray, Density, Sonic, Neutron, Other (Describe) _____			
Name of Organization Running Log			

TYPE OF COMPLETION: (Circle One or More): Gravel Packed, Underreamed, Telescoped, <input checked="" type="checkbox"/> Natural Development, Open Hole, Other (Describe) _____			
WELL GROUTED TO A DEPTH OF 10 FEET Type Grout (circle one): Cement, Bentonite, or Mix			

GEOLOGIC DATA (Office Use Only)			
Surface Elev.	Geologic Unit	Unit Thickness	Depth to Top
Subs. SWL	Date	Analysis	Aquifer Test
Driller's Remarks			

SCREEN DATA		
Diameter - Inches 2"	Length - Feet 10'	Slot Size - Inches .08
Screen Type PVC sch 40	Depth to Bottom - Feet 119'	


Top of Lap Pipe or Reduction in Casing	
FEET	IF TELESCOPED OR MORE THAN ONE SCREEN: USE BACK PAGE

DESCRIPTION OF FORMATIONS ENCOUNTERED	FROM	TO
top soil	1'	2'
red clay	2'	20'
red soap stone	20'	30'
white & brown soap stone	30'	99'
coarse white sand	99'	119'

FORMATIONS (Continued)	FROM	TO
RECEIVED		
NOV 29 2000		
Dept. of Environmental Quality Office of Land & Water Resources		
IF MORE SPACE IS NEEDED, USE BACK		

If well telescopes please
sketch and show depths.

GROUND LEVEL

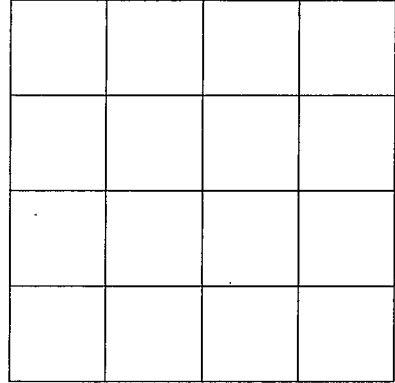


SECTION _____

Please indicate well location X.

ADDITIONAL INFORMATION

A series of horizontal lines providing space for additional information.

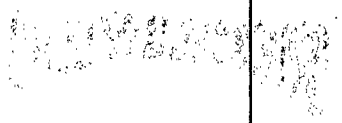

If more than one screen,
show location of each on sketch.