

MISSISSIPPI DEPARTMENT OF NATURAL RESOURCES

Bureau of Land and Water Resources

Southport Mall

P.O. Box 10631

Jackson, Mississippi 39209

WATER WELL DRILLERS LOG

STONE
G <del>XXXX</del>

11-5 1985 Parwell Anderson Stone  
 date well completed firm name county well located

LANDOWNER: <u>Wayne Kirkland</u>	description of formations encountered	from	to
<u>Herbinston</u>			
	TOP Soil	0	3
	Clay	3	19
	SAND	19	34
	Clay	34	79
	SAND	79	105

(mailing address)

WELL LOCATION:

sec. — T — N R — E  
 S W

(distance) miles (direction) of (nearest town)

WELL PURPOSE: Home  
 (home, irrigation, municipal, industrial)

WELL COMPLETION DATA:

- (1) diameter (inches) 2
- (2) total depth (feet) 105
- (3) static water level (feet) 58 below above top of ground.

(4) casing Pvc 100  
 (material) (depth)  
 (size) If telescope see back.

(5) screen 5 100  
 (length) (depth to top)  
2 Pvc  
 (size) (material)

(6) pump 1 10  
 (HP) (yield gpm)  
Elec  
 (type power)

(7) electric log (yes or no)

(organization running log)

(8) how well bottom plugged Cap


RECEIVED  
 JUN 17 1986

Department of Natural Resources  
 Bureau of Land & Water Resources

DRILLERS REMARKS:

If well telescopes please sketch and show depths.

GROUND LEVEL

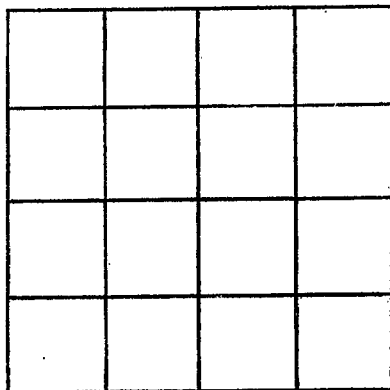

SECTION \_\_\_\_\_

Please indicate well location X.

ADDITIONAL INFORMATION

If more than one screen,  
show locations of each on sketch.