

STONE
G3

MISSISSIPPI BOARD OF WATER COMMISSIONERS

5-12-61

WATER WELL DRILLERS LOG

CODED

Date: 5-12, 1961, Driller: Harrisburg Butore County Stone
877 (Name)

(1) Owner of Land: Albert A. Kirkland
(Name)
Rt 1 Beckerton, Miss.
(Address)

(2) Location: 1/4, 1/4, Sec. 5 T3 R11,
5 miles S of Wiggins
(distance) (direction) (Nearest Town)

(3) Topography: X
(Hilly) (Flat) (Level)

(4) Purpose of Well: domestic
(Domestic Irrigation
Municipal, Industrial, Other).

Description & Color of Materials Sand, Clay, Red Clay, Shell, etc.	Thick- ness Feet	Depth Feet
<u>Red sand</u>	<u>0-8</u>	
<u>white clay</u>	<u>8-50</u>	
<u>white sand</u>	<u>50-88</u>	

Information upon completion of well:

(1) Diameter 2 inches.

(2) Total Depth 88 feet.

(3) Water Level 18 feet below top of ground:

(4) Cased to _____, Size _____

(5) Screen: Size 2", Length 10'

(6) Were any formations sealed against pollution?


_____ yes, X no.

If YES depth of formation _____

Why _____

Drillers Remarks: _____

CODED

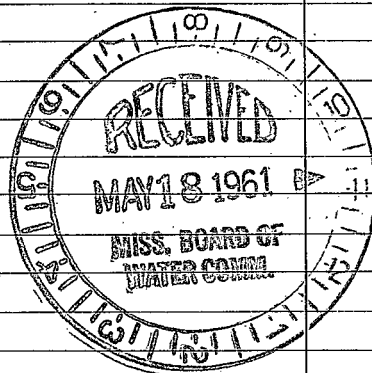

(Use Back Side)

Well No.

