

68

6-4-64

WATER WELL DRILLERS LOG

CODED

Date: June 4, 1964, Driller: Jay Lott County Stone

921

(Name)

(1) Owner of Land: WILLIAM C. COOPER

(Name)

PERKINSTON, MISSISSIPPI RT. 1

(Address)

(2) Location: 1/4, 1/4, Sec. 8 T3R11

3 1/2 miles EAST of PERKINSTON

(distance) (direction) (Nearest Town)

(3) Topography: (Hilly) (Flat) (Level)

(4) Purpose of Well: DOMESTIC (Domestic Irrigation, Municipal, Industrial, Other)

Information upon completion of well:

- (1) Diameter 2 inches.
(2) Total Depth 83 feet.
(3) Water Level 15 feet below top of ground.
(4) Cased to 2 inch, Size 2 inch, 6 Foot
(5) Screen: Size BRONZE, Length 6 FT
(6) Were any formations sealed against pollution? yes, no.

If YES depth of formation

Why

Drillers Remarks:


Description & Color of Materials Sand, Clay, Red Clay, Shell, etc.

Thickness Feet

Depth Feet

0-18- YC
18-40- R-S
40-60- R-C
60-83- W-S
15 Ft to Water

CODED

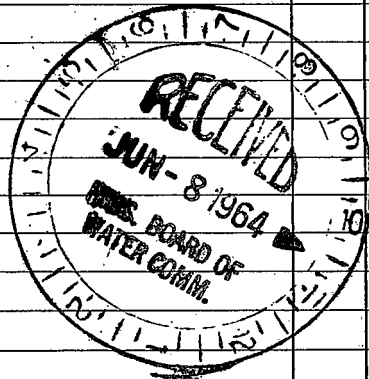

(Use Back Side)

Well No.

