

Stone
G10
12-67

MISSISSIPPI
BOARD OF WATER COMMISSIONERS
416 North State Street
Jackson, Mississippi 39201

WATER WELL DRILLERS LOG

12-15 1967 date well completed
Sutter Well Works firm name
Stone county well located

LANDOWNER: THOS. ANDERSON

Gulfport, Miss.

(mailing address)

WELL LOCATION:

sec. 29 T 3 S R 11 W
2 miles SE of Jew Dale
(distance) (direction) (nearest town)

WELL PURPOSE: home
(home, irrigation, municipal, industrial)

WELL COMPLETION DATA:

- (1) diameter (inches) 2 X 4
- (2) total depth (feet) 241
- (3) static water level (feet) 160 ^{below} ~~above~~ top of ground.
- (4) casing galv. steel, 231' (material) (depth)
4" (size) if telescope see back.
- (5) screen 10' 231' (length) (depth to top)
2" stainless steel (size) (material)
- (6) pump 1 15 (HP) (yield gpm)
elec (type power)
- (7) electric log no (yes or no)

(organization running log)


(8) how well bottom plugged B.P. Valve

DRILLERS REMARKS:

description of formations encountered

from to

Surface Sand	0	20
Clay	20	60
Sand	60	71
Clay	71	185
Sand	185	241

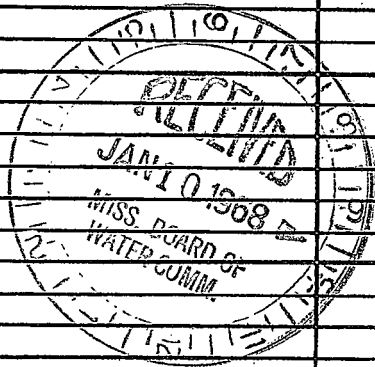

If well telescopes please sketch and show depths.

GROUND LEVEL

2 3/4" GALV. STEEL CASING

2 x 10" S.S. STRAINER

	X		

SECTION 29

Please indicate well location X.

ADDITIONAL INFORMATION

If more than one screen, show locations of each on sketch.