

CODED

MISSISSIPPI
BOARD OF WATER COMMISSIONERS
416 North State Street
Jackson, Mississippi 39201

WATER WELL DRILLERS LOG

Stone
G 13
3-67

3-6 1967 L. W. Smith Stone
date well completed firm name county well located

LANDOWNER:

description of formations encountered

from to

Horace Hatten
Routel Wiggins Mess
(mailing address)

Top Soil
Clay
Sand
Clay
Sand
Clay

0 1
1 14
14 25
25 30
30 52
52 54

WELL LOCATION:

sec. 34 T 9 N R 11 E
6 miles S E of Perkinsto
(distance) (direction) (nearest town)

WELL PURPOSE:

(home, irrigation, municipal, industrial)

WELL COMPLETION DATA:

- (1) diameter (inches) 2"
- (2) total depth (feet) 52'
- (3) static water level (feet) 43' below above top of ground.
- (4) casing Plastic (material) (depth)

if telescope see back. (size)

- (5) screen 5' (length) (depth to top) 2" Plastic (size) (material)


- (6) pump 1 (HP) 7 (yield gpm) Electric (type power)

- (7) electric log no (yes or no)

(organization running log)


- (8) how well bottom plugged Backward

DRILLERS REMARKS:

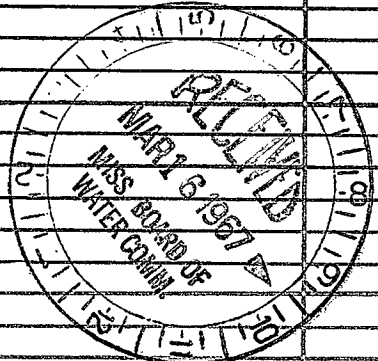

If well telescopes please sketch and show depths.

GROUND LEVEL

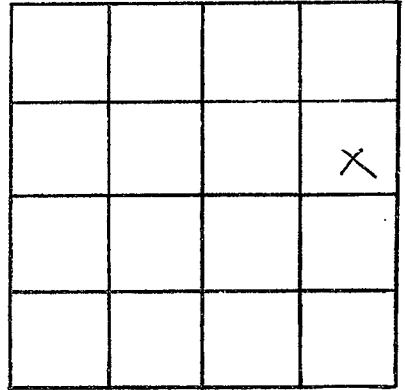

SECTION 34

Please indicate well location X.

ADDITIONAL INFORMATION

If more than one screen, show locations of each on sketch.