

STONE
G-14
5-28-70

MISSISSIPPI
BOARD OF WATER COMMISSIONERS
416 North State Street
Jackson, Mississippi 39201

CODED

WATER WELL DRILLERS LOG

5-38
date well completed

1970 Perwell Anderson
firm name

Stone
county well located

LANDOWNER: <u>James M. Bastie</u> <u>Perkinston</u>	description of formations encountered	from	to
	<u>TOP SOIL</u>	<u>0</u>	<u>2</u>
	<u>Red Clay</u>	<u>2</u>	<u>24</u>
	<u>Fine Sand</u>	<u>24</u>	<u>30</u>
	<u>Red Clay</u>	<u>30</u>	<u>45</u>
	<u>Fine Sand</u>	<u>45</u>	<u>61</u>
	<u>Red Clay</u>	<u>61</u>	<u>68</u>
	<u>Fine Sand</u>	<u>68</u>	<u>79</u>
	<u>Coarse Sand</u>	<u>79</u>	<u>97</u>
(mailing address)			
WELL LOCATION:			
sec. <u>29</u> T. <u>3</u> N R. <u>11</u> E			
<u>4</u> miles <u>E</u> of <u>Perkinston</u>			
(distance) (direction) (nearest town)			
WELL PURPOSE: (home, irrigation, municipal, industrial)			
WELL COMPLETION DATA:			
(1) diameter (inches) <u>2</u>			
(2) total depth (feet) <u>97</u>			
(3) static water level (feet) <u>40</u> below above top of ground.			
(4) casing <u>Plastic</u> <u>91</u> (material) (depth)			
_____ if telescope see back. (size)			
(5) screen <u>6</u> <u>91</u> (length) (depth to top)			
<u>2"</u> <u>Plastic</u> (size) (material)			
(6) pump <u>1</u> <u>9</u> (HP) (yield gpm)			
<u>Elect</u> (type power)			
(7) electric log _____ (yes or no)			
_____ (organization running log)			
(8) how well bottom plugged <u>Rich Wash Valve</u>			
DRILLERS REMARKS:			


CODED

JUN 11 1971

MISS. Bd. of
WATER COMM.

If well telescopes please
sketch and show depths.

GROUND LEVEL

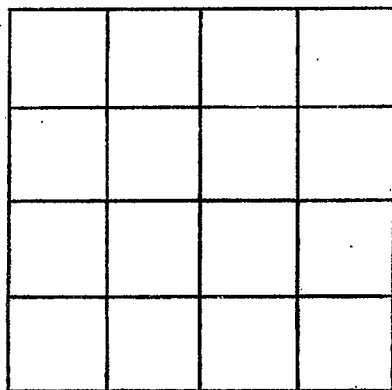

SECTION _____

Please indicate well location X.

ADDITIONAL INFORMATION

If more than one screen,
show locations of each on sketch.