

MISSISSIPPI  
BOARD OF WATER COMMISSIONERS  
416 North State Street  
Jackson, Mississippi 39201

**CODED**

WATER WELL DRILLERS LOG


STONE  
G 15  
7-31-70

7-31 1970 Parnell Anderson Stone  
date well completed firm name county well located

LANDOWNER: <u>Ne 165 T. Breland</u>	description of formations encountered	from	to
<u>Route 1</u>	<u>Top Soil</u>	<u>0</u>	<u>2</u>
<u>Perkinston</u> (mailing address)	<u>Red Clay</u>	<u>2</u>	<u>21</u>
WELL LOCATION:	<u>Fine Sand</u>	<u>21</u>	<u>39</u>
sec. <u>2</u> T. <u>3</u> S. R. <u>11</u> E. W.	<u>Red Clay with sand str.</u>	<u>39</u>	<u>70</u>
<u>7</u> miles <u>E</u> of <u>Wiggins</u> (distance) (direction) (nearest town)	<u>Fine Sand</u>	<u>70</u>	<u>92</u>
WELL PURPOSE: <u>Home</u> (home, irrigation, municipal, industrial)	<u>Pink Clay</u>	<u>92</u>	<u>96</u>
WELL COMPLETION DATA:	<u>Coarse Sand &amp; Gravel</u>	<u>96</u>	<u>114</u>
(1) diameter (inches) <u>2"</u>	<b>CODED</b>		
(2) total depth (feet) <u>114</u>			
(3) static water level (feet) <u>58</u> below top of ground.			
(4) casing <u>Plastic 108</u> (material) (depth)			
_____ (size) if telescope see back.			
(5) screen <u>6</u> <u>108</u> (length) (depth to top)			
<u>2"</u> <u>Plastic</u> (size) (material)			
(6) pump <u>1</u> <u>8</u> (HP) (yield gpm)			
<u>Elect</u> (type power)			
(7) electric log _____ (yes or no)			
_____ (organization running log)			
(8) how well bottom plugged <u>Backwash Valve</u>			
DRILLERS REMARKS:	<p>JUN 11 1971</p> <p>MISS. Bd. OF WATER COMMS.</p>		

If well telescopes please sketch and show depths.

GROUND LEVEL

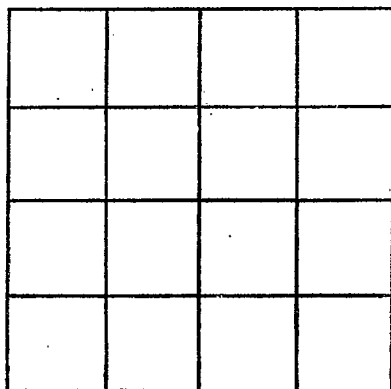

SECTION \_\_\_\_\_

Please indicate well location X.

ADDITIONAL INFORMATION

If more than one screen,  
show locations of each on sketch.