

CODED

MISSISSIPPI  
BOARD OF WATER COMMISSIONERS  
416 North State Street  
Jackson, Mississippi 39201

CODED

WATER WELL DRILLERS LOG

Stone  
G 18  
10-68

19 Stone  
date well completed

Parnell Anderson  
firm name

Stone  
county well located

LANDOWNER: Mathie Gay  
Perkinston Miss

description of fomations  
encountered

from to

Top Soft Sand	0	8
Clay	8	20
Fine Sand	20	75
Coarse Sand	75	83

(mailing address)

WELL LOCATION:

sec. 18 T. 3 N. S. R. 11 W. of Perkinston  
(distance) (direction) (nearest town)

WELL PURPOSE: Home  
(home, irrigation, municipal, industrial)

CODED

WELL COMPLETION DATA:

- (1) diameter (inches) 2
- (2) total depth (feet) 83
- (3) static water level (feet) 14 below above top of ground.
- (4) casing Plastic, 73,  
(material) (depth)

         if telescope see back.  
(size)

- (5) screen 6', 73  
(length) (depth to top)  
2", Plastic  
(size) (material)

- (6) pump 3/4, 9  
(HP) (yield gpm)


Electric  
(type power)

- (7) electric log           
(yes or no)

          
(organization running log)

- (8) how well bottom plugged Backwash Valve

DRILLERS REMARKS:

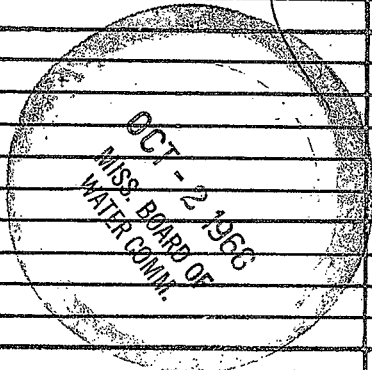

If well telescopes please sketch and show depths.

GROUND LEVEL

X			

SECTION 18

Please indicate well location X.

ADDITIONAL INFORMATION

If more than one screen, show locations of each on sketch.