

CODED

Stone  
G 19  
11-29-68

MISSISSIPPI  
BOARD OF WATER COMMISSIONERS  
416 North State Street  
Jackson, Mississippi 39201

CODED

WATER WELL DRILLERS LOG

11-29 1968 Parnell Anderson Stone  
date well completed firm name county well located

LANDOWNER: Ellis V. Smith  
Route 1 Perkinston  
Miss  
(mailing address)

| description of formations encountered | from | to |
|---------------------------------------|------|----|
| TOP Soil                              | 0    | 4  |
| Red Sandy Clay                        | 4    | 17 |
| Coarse Sand                           | 17   | 26 |
| Red Clay                              | 26   | 39 |
| Fine Sand + Clayst.                   | 39   | 58 |
| Pink Clay                             | 58   | 61 |
| Fine Sand                             | 61   | 69 |
| Coarse Sand                           | 69   | 78 |

WELL LOCATION:  
sec. 5 T. 3 N. R. 11 W.  
S W  
4 miles SE of Wiggins  
(distance) (direction) (nearest town)

WELL PURPOSE:  
(home, irrigation, municipal, industrial)

- WELL COMPLETION DATA:
- (1) diameter (inches) 2"
  - (2) total depth (feet) 84
  - (3) static water level (feet) 30 below top of ground.
  - (4) casing 2 (material), 78' (depth),  
if telescope see back.  
(size)
  - (5) screen 6' (length), 78' (depth to top),  
2" (size), Plastic (material)
  - (6) pump 1 (HP), 10 (yield gpm),  
Elect (type power)
  - (7) electric log \_\_\_\_\_  
(yes or no)  
(organization running log)
  - (8) how well bottom plugged  
backwash valve


CODED

FEB - 7 1969  
MISS. BR. OF WATER COMMISSIONERS

DRILLERS REMARKS:

If well telescopes please sketch and show depths.

GROUND LEVEL

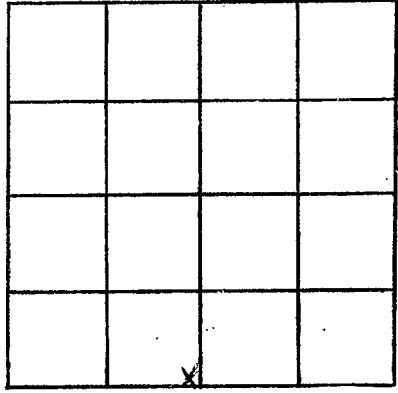

SECTION 5

Please indicate well location X.

ADDITIONAL INFORMATION

Lined area for additional information.

If more than one screen, show locations of each on sketch.