

**MISSISSIPPI
BOARD OF WATER COMMISSIONERS**
416 North State Street
Jackson, Mississippi 39201

CODED

WATER WELL DRILLERS LOG

Stone
Y 20
4-6-68

4-6 1968 L W Smith Stone
date well completed firm name county well located

LANDOWNER:
CP Stagg
Perkinston
(mailing address)

description of formations encountered	from	to
<u>Top Soil</u>	<u>0</u>	<u>2</u>
<u>Clay</u>	<u>2</u>	<u>37</u>
<u>Sand</u>	<u>37</u>	<u>52</u>
<u>Sand & Gravel</u>	<u>52</u>	<u>74</u>
<u>Clay</u>		

WELL LOCATION:
sec. 31 T. 9 S. R. 11 W.
2 miles SW of Perkinston
(distance) (direction) (nearest town)

WELL PURPOSE:
(home, irrigation, municipal, industrial)

WELL COMPLETION DATA:

- (1) diameter (inches) 2
- (2) total depth (feet) 74
- (3) static water level (feet) 48 below top of ground.
- (4) casing Plastic 74'
(material) (depth)
 if telescope see back.
(size)
- (5) screen 5 69
(length) (depth to top)
2 Plastic
(size) (material)
- (6) pump 1 12
(HP) (yield gpm)
Electric
(type power)
- (7) electric log
(yes or no)

(organization running log)
- (8) how well bottom plugged Backw.

CODED


FEB 4 1968

MISS. BD. OF
WATER COMM.

DRILLERS REMARKS:

If well telescopes please sketch and show depths.

GROUND LEVEL

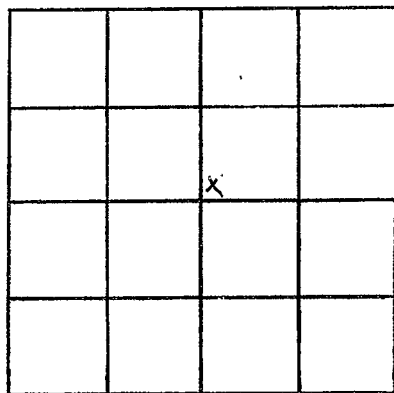

SECTION 31

Please indicate well location X.

ADDITIONAL INFORMATION

If more than one screen, show locations of each on sketch.