

STONE  
G 21  
8-6-68

MISSISSIPPI  
BOARD OF WATER COMMISSIONERS  
416 North State Street  
Jackson, Mississippi 39201

WATER WELL DRILLERS LOG

8-6 1968 B W Smith Stone  
date well completed firm name county well located

LANDOWNER:  
Albert Stockman  
(mailing address)

WELL LOCATION:  
sec. 18 T 3 S R 11 W  
(distance) miles (direction) of (nearest town)

WELL PURPOSE:  
(home, irrigation, municipal, industrial)

WELL COMPLETION DATA:  
(1) diameter (inches) 2  
(2) total depth (feet) 9-14  
(3) static water level (feet) flow below above top of ground.  
(4) casing Plastic (material) (depth)  
If telescope see back.  
(size)  
(5) screen 5' 209 (length) (depth to top)  
(size) (material)  
(6) pump flow 1/2 (HP) (yield gpm)  
(type power)  
(7) electric log (yes or no)  
(organization running log)  
(8) how well bottom plugged Beckw.


description of formations encountered	from to	
	CODED	
Top 8		1
Fine Sand	1	12
Clay	12	30
Sand	30	90
Clay	90	160
Sand	160	214
Clay		

DRILLERS REMARKS:

FEB - 4 1968  
MISS. RD. OF  
WATER COMM.

If well telescopes please sketch and show depths.

GROUND LEVEL

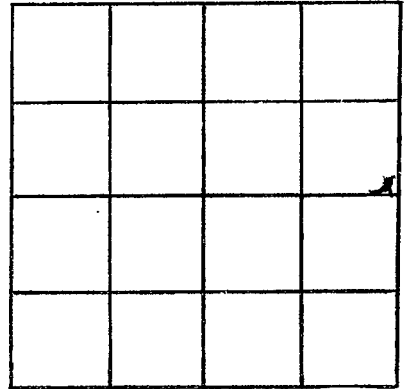

SECTION \_\_\_\_\_

Please indicate well location X.

ADDITIONAL INFORMATION

If more than one screen, show locations of each on sketch.