

STONE
G 23
1-30-69

MISSISSIPPI
BOARD OF WATER COMMISSIONERS
416 North State Street
Jackson, Mississippi 39201

CODED

WATER WELL DRILLERS LOG

Jan. 30 1969 Parnell Anderson Stone
date well completed firm name county well located

LANDOWNER: J. J. Preston

description of formations encountered	from	to
TOP SOIL	0	3
CLAY	3	18
FINE SAND	18	70
CORSE SAND	70	85

Rt A Perkinston Miss
(mailing address)

WELL LOCATION:
sec. 14 T 3 S R 11 W
7 miles SE of Wiggins
(distance) (direction) (nearest town)

WELL PURPOSE: Home
(home, irrigation, municipal, industrial)

WELL COMPLETION DATA:

- (1) diameter (inches) 2
- (2) total depth (feet) 85
- (3) static water level (feet) 30 below top of ground.
- (4) casing Plastic, 49 (material) (depth)
- (size) if telescope see back.
- (5) screen 6 (length) 79 (depth to top)
- 2 (size) Plastic (material)
- (6) pump 1 (HP) 10 (yield gpm)
- Elect (type power)
- (7) electric log no (yes or no)

(organization running log)

(8) how well bottom plugged Backwash Valve

DRILLERS REMARKS:


CODED

MAR 20 1969

MISS. DE. OF WATER CONTROL

If well telescopes please sketch and show depths.

GROUND LEVEL

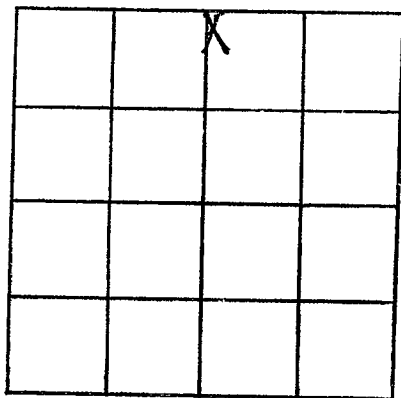

SECTION 24

Please indicate well location X.

ADDITIONAL INFORMATION

If more than one screen, show locations of each on sketch.