

**MISSISSIPPI
BOARD OF WATER COMMISSIONERS**
416 North State Street

Jackson, Mississippi 39201

Jamell Anderson
WATER WELL DRILLERS LOG

STONE
G 24
2-5-69

2-5 1969 *Big Level Lodge* Stone
date well completed firm name county well located

LANDOWNER: *Big Level Lodge*
Route A, Perkinston

(mailing address)

WELL LOCATION:

sec 1 T 3 R 11
S W
6 miles E of Wiggins
(distance) (direction) (nearest town)

WELL PURPOSE: Lodge
(home, irrigation, municipal industrial)

WELL COMPLETION DATA:

- (1) diameter (inches) 2
- (2) total depth (feet) 86
- (3) static water level (feet) 20 below
top of ground.
- (4) casing Plastic, 80
(material) (depth)
- if telescope see back.
(size)
- (5) screen 6', 80
(length) (depth to top)
- 2", Plastic
(size) (material)
- (6) pump 1/2 6
(HP) (yield gpm)
- Elect
(type power)
- (7) electric log
(yes or no)

(organization running log)

(8) how well bottom plugged
Backwash

DRILLERS REMARKS:

description of formations
encountered

from to


TOP Soil	0	4
Sandy Clay	4	18
Coarse Sand	18	26
Red Clay	26	40
Fine Sand	40	61
Pink Clay	61	64
Fine Sand	64	75
Coarse Sand	75	86

INDEXED

MAR 20 1969
MISS. Bd. of
WATER COM.

If well telescopes please
sketch and show depths.

GROUND LEVEL

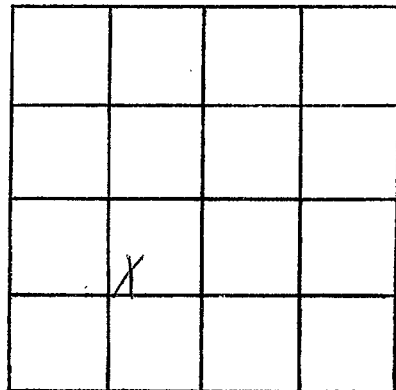

SECTION 1

Please indicate well location X.

ADDITIONAL INFORMATION

If more than one screen,
show locations of each on sketch.